


T. 3&4S. R. 2W. W.M.

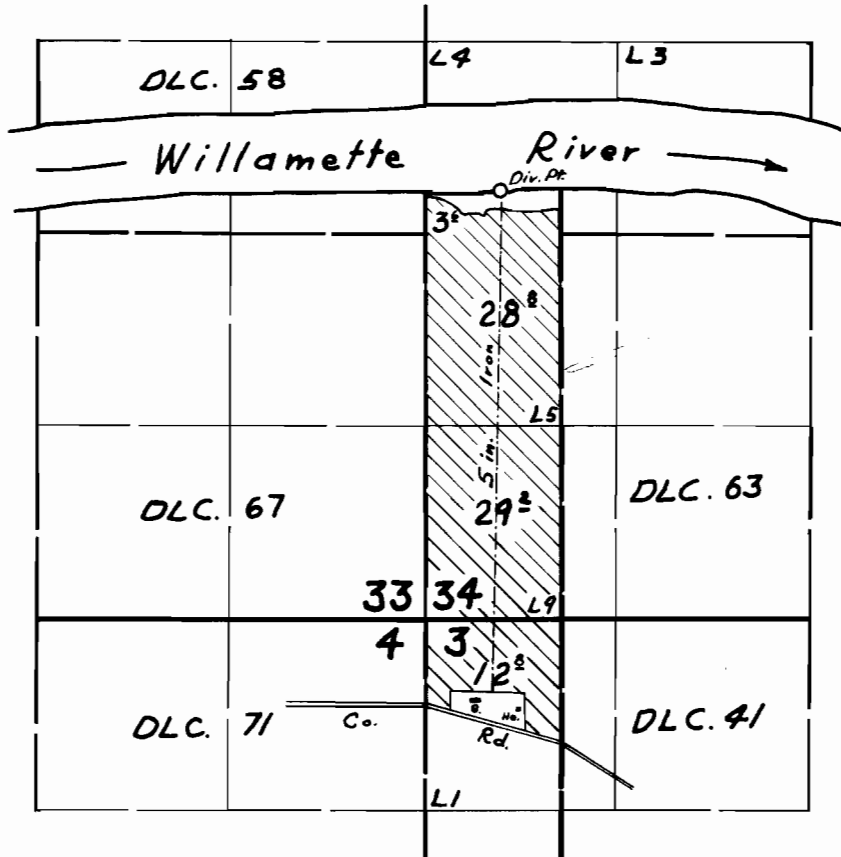

**FINAL PROOF SURVEY**

UNDER

Application No. 24001 Permit No. 18931

IN NAME OF

LAWRENCE & ROBBINS

Surveyed 26 Sept. 1956, by M. Bish

DFN-2D-85

RB