


T. 4 S. R. 1 W. W. M.

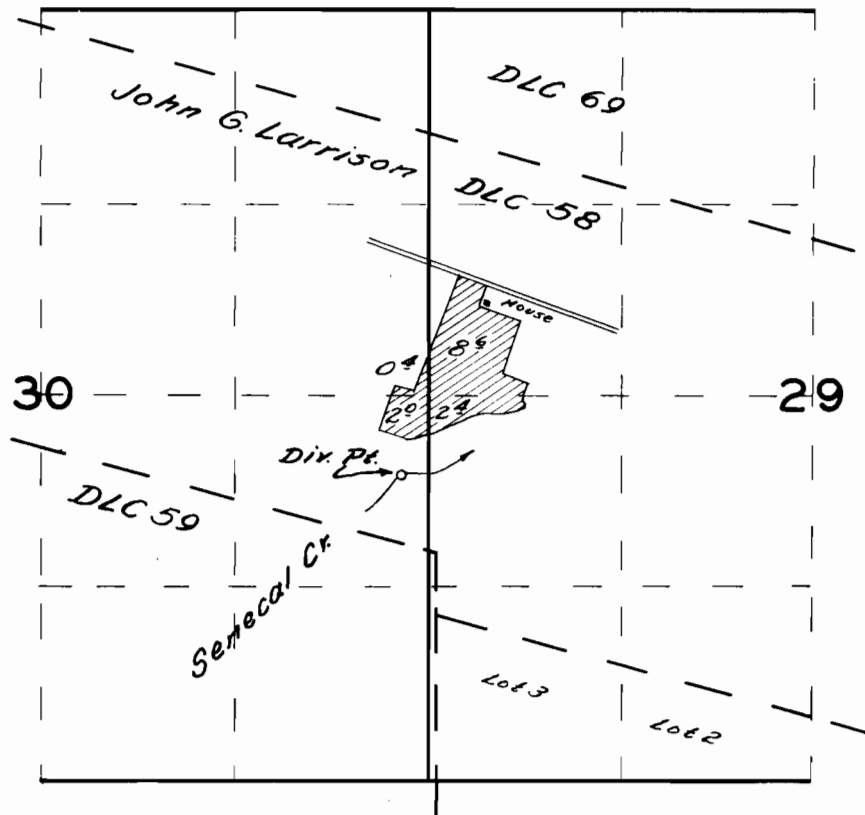

**FINAL PROOF SURVEY**

UNDER

Application No. 24089 Permit No. 18960

IN NAME OF

O. C. LESTER JR.

Surveyed Sept. 24, 1956, by M. Bish