


T. 5 S. R. 8 W. W. M.

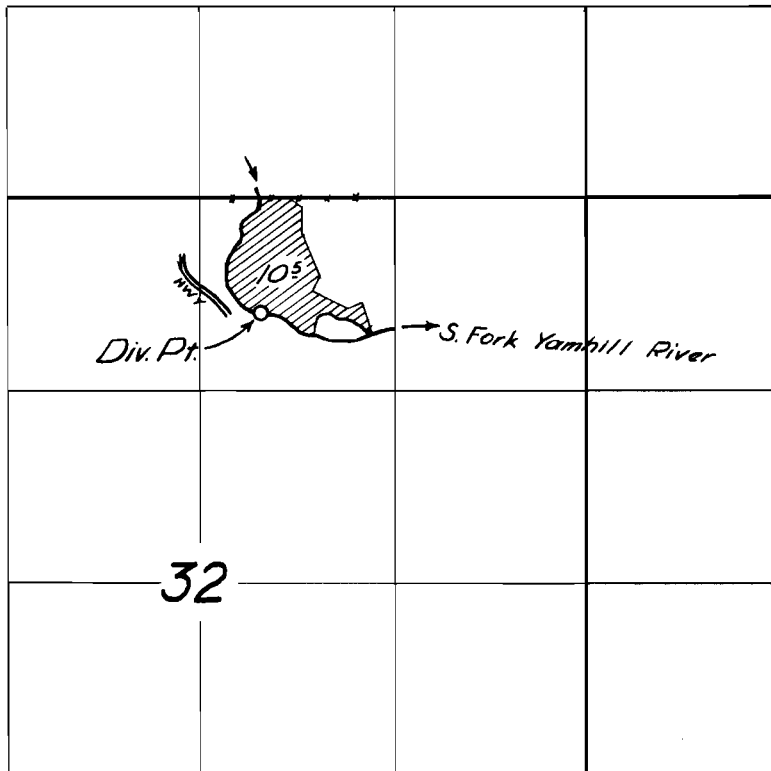

FINAL PROOF SURVEY

UNDER

Application No. 24090 Permit No. 18970

IN NAME OF

CALLIE B. HEIDER

Surveyed 27 Mar. 1956, by [Signature]