


T. 6 S. R. 1 W. W. M.

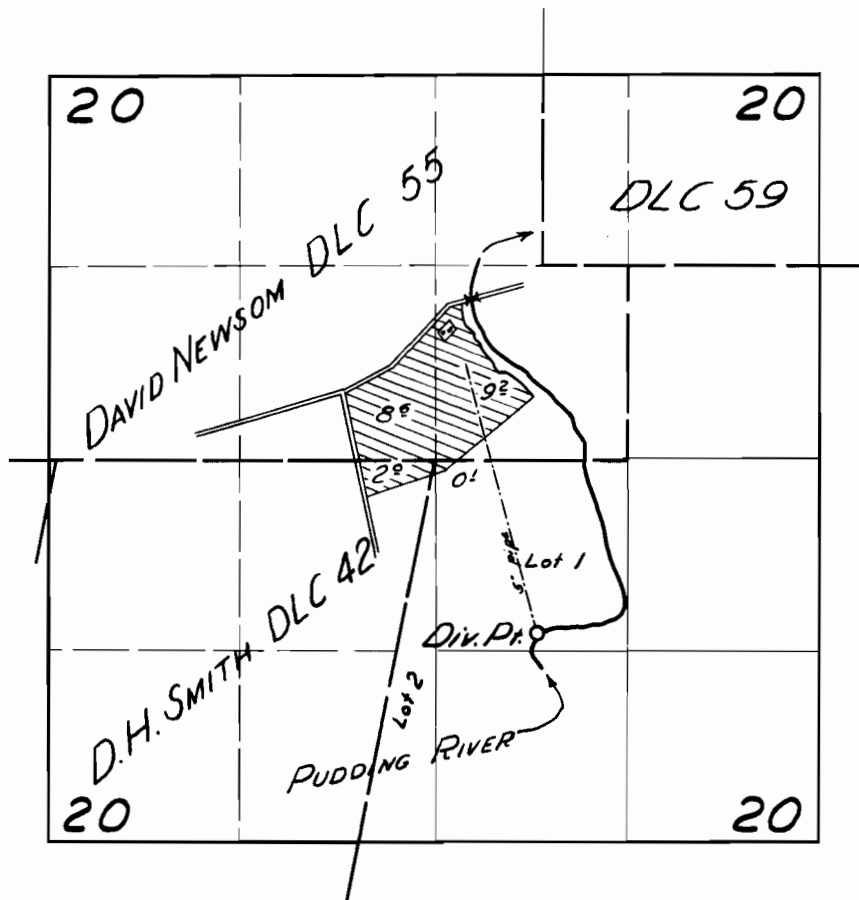

FINAL PROOF SURVEY

UNDER

Application No. 24116 Permit No. 18987

IN NAME OF

GEORGE VACHTER

Surveyed 7 June 1956, by *D. Whitby*