


T. 5 N R. 4 W W.M.

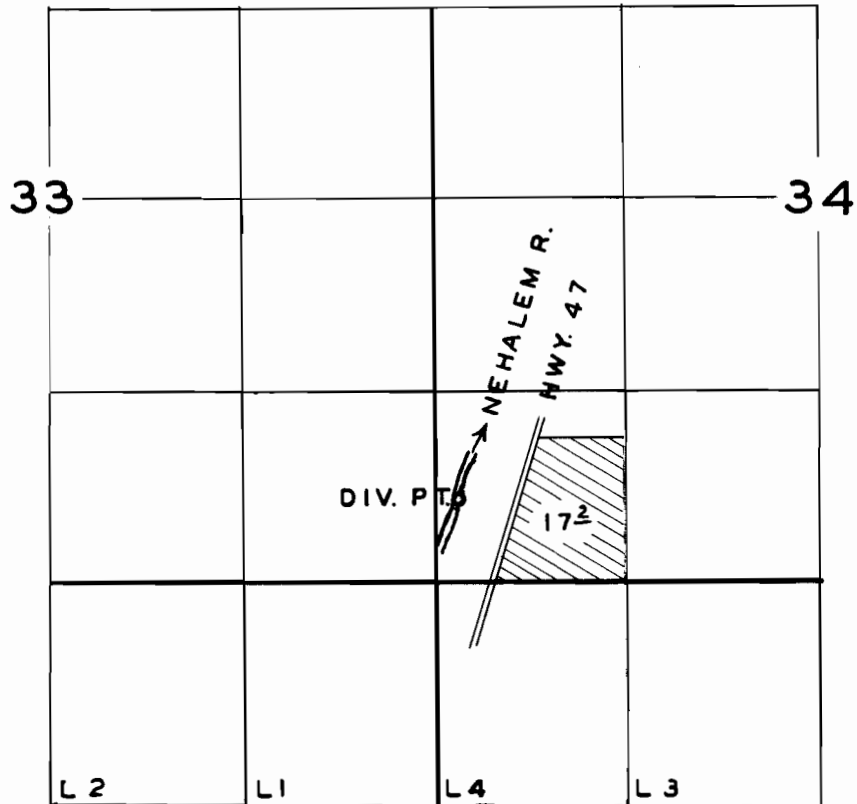

FINAL PROOF SURVEY
UNDER

Application No. 24176 Permit No. 19012
IN NAME OF

RALPH MCKEE

Surveyed AUG. 31 1956, by R. H. W. H. T. B. Y.

1956 V
P. W. J.