


T.5S.R.2&3E.W.M

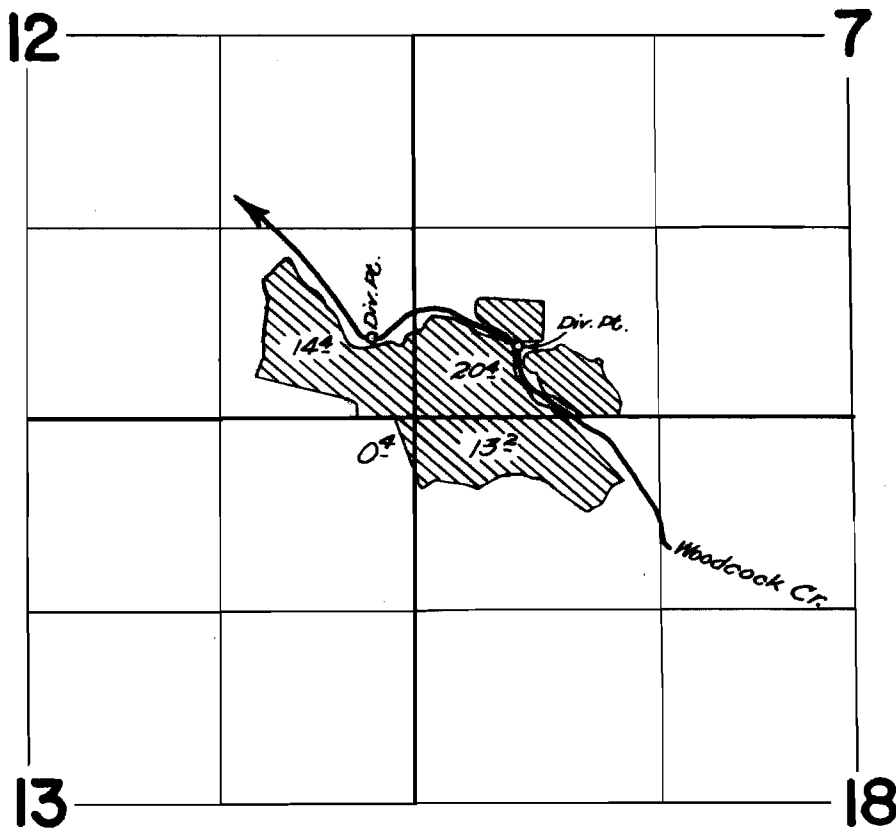

FINAL PROOF SURVEY UNDER

Application No. 23275 Permit No. 19075
IN NAME OF

..... REX COLEMAN

Surveyed March 28 1956, by R. D. Best.

RF