


T. 6 S. R. 1 W.W.M.

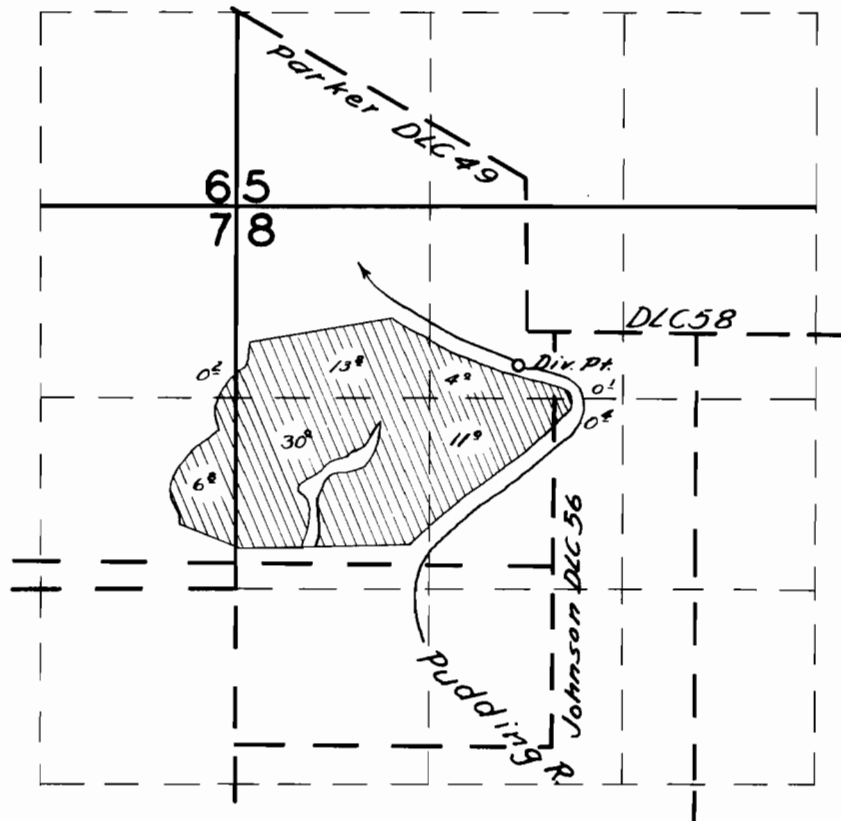

FINAL PROOF SURVEY

UNDER

Application No. 23976.. Permit No. 19098..

IN NAME OF

J. N. Adams

Surveyed *May 25, 1956*, by *G. O. Bartels*...