


T. 4 S. R. 1 W. W. M.

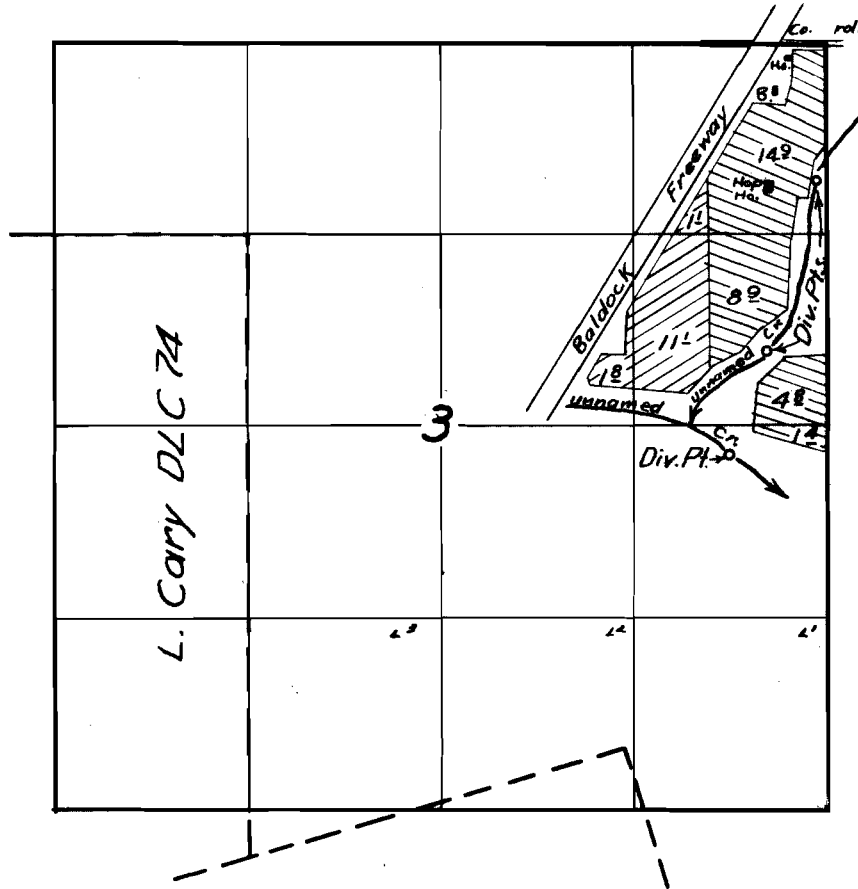

**FINAL PROOF SURVEY**

UNDER

Application No. <sup>24294</sup> ~~25422~~ Permit No. <sup>19220</sup> ~~20001~~.....

IN NAME OF

.....Mary Lofgren.....

Surveyed 21 Sept. 1956, by Tom Bishop.....

