


T. 5S. R. 3E. WM.

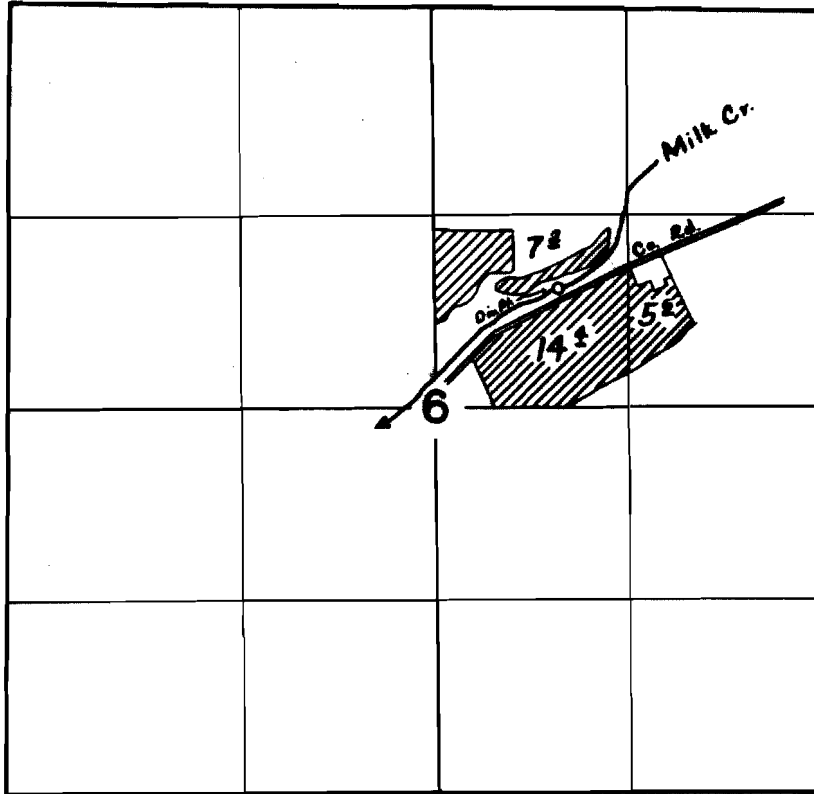

**FINAL PROOF SURVEY**

UNDER

Application No. 24355 Permit No. 19229

IN NAME OF

WM. SCHMITZ

Surveyed 3 Apr. 1956, by R. D. Best

DFK-ID-92

2004