


T. 13 S. R. 27 E. W. M.

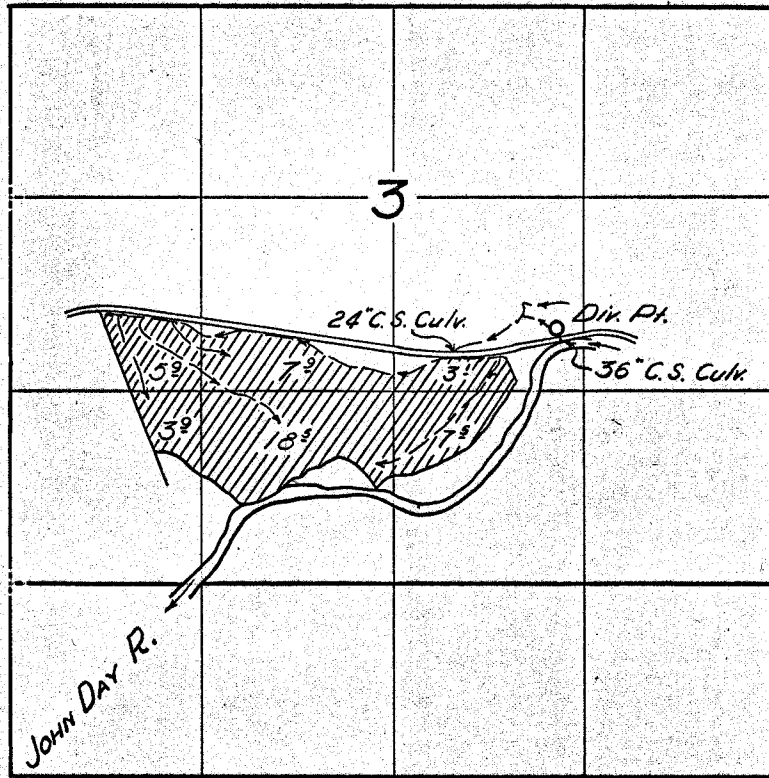

**FINAL PROOF SURVEY**

UNDER

Application No. 24445 Permit No. 19273

IN NAME OF

MARY S. LIVEIRA

Surveyed 3 Nov. 1956, by C. A. [Signature]