


T.25 S R.6 W. W.M.

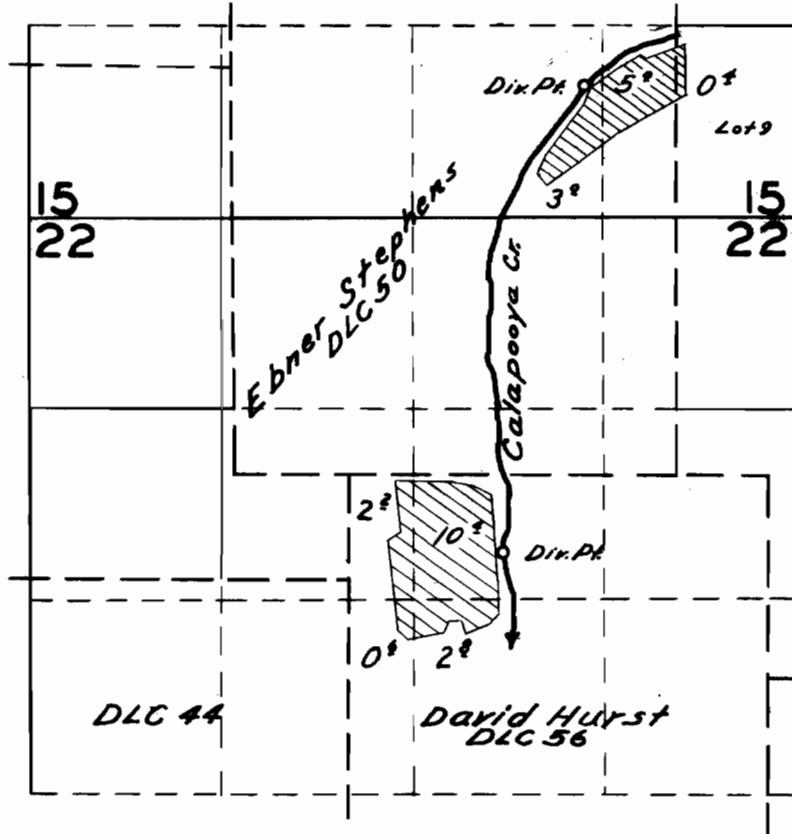

**FINAL PROOF SURVEY**

UNDER

Application No. *24,580*. Permit No. *19,325*.  
IN NAME OF

*F. G. Moore*

Surveyed *Aug. 23*, 1956, by *G. O. Bartels*