


T.9-10 S. R. 45 E.W.M.

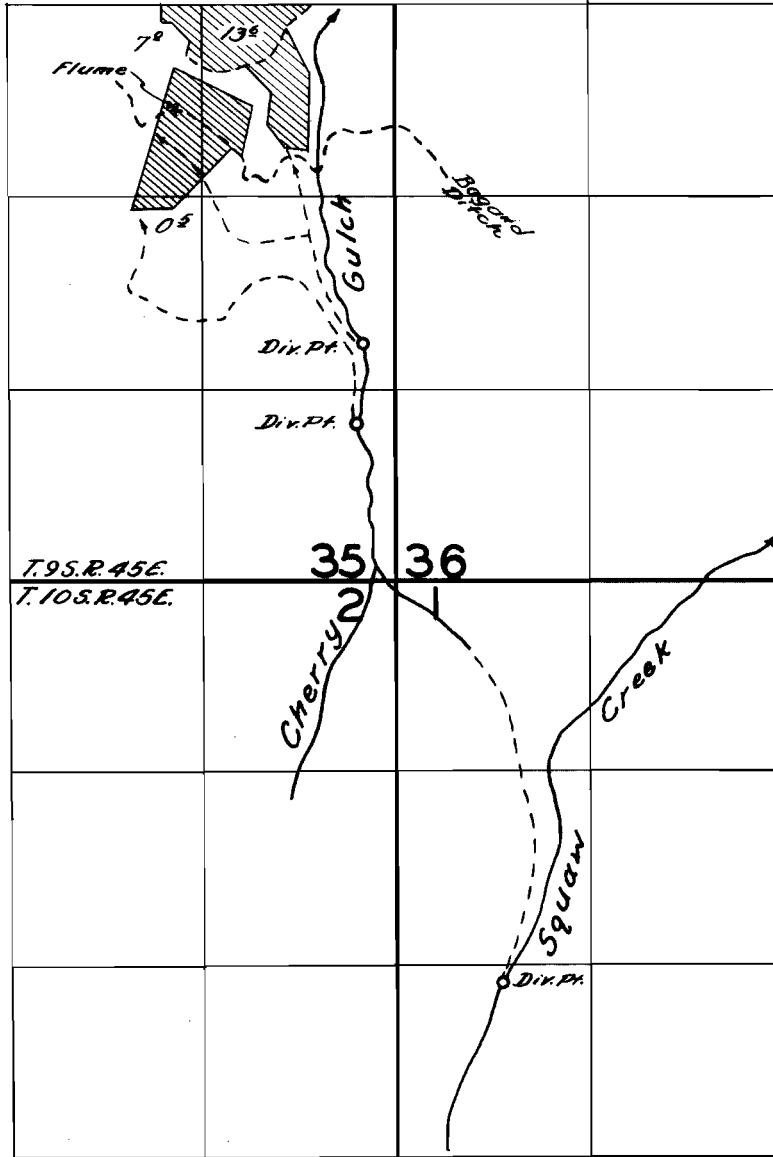

FINAL PROOF SURVEY
UNDER

Application No. *24212*..... Permit No. *19338*.....
IN NAME OF

.....*Anson E. Powell*.....

Surveyed *June 2*... 1956., by *M. Bisk*.....

888-9N-72