


T. 4 S. R. 3 W. W. M.

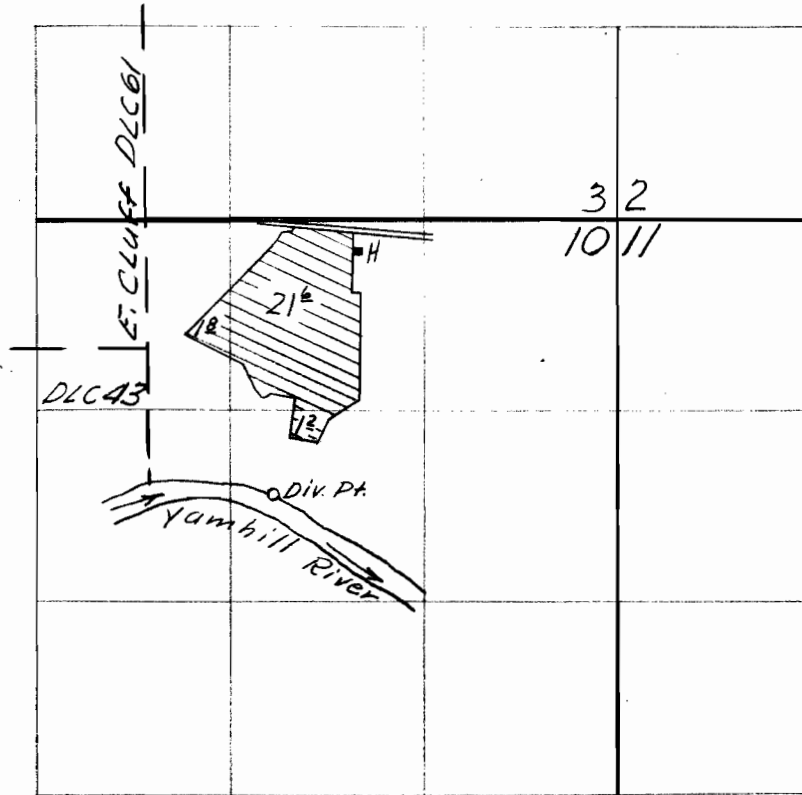

Final Proof Survey  
Under

Application No. 24649 Permit No. 19395  
In Name Of

Arthur G. & Esther Sohrweid

Surveyed June 7 1955 by T. Jones