


T. 6 S. R. 1. W. W. M.

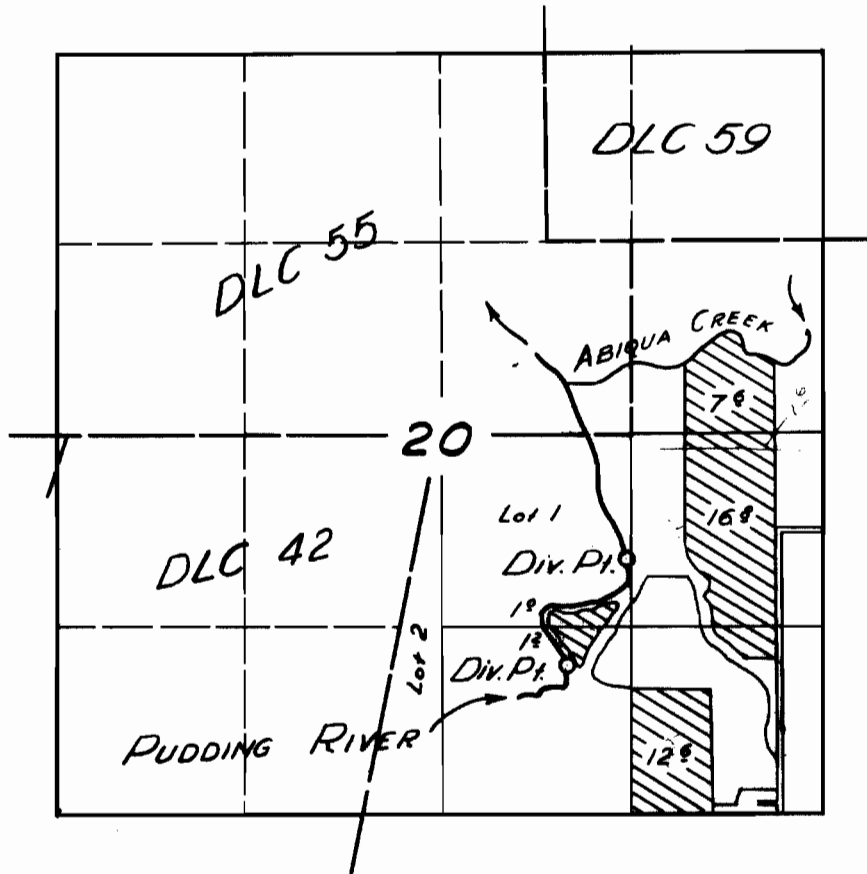

FINAL PROOF SURVEY
UNDER

Application No. 24657 Permit No. 19400

IN NAME OF

HAROLD SATERN

Surveyed 7 June 1956, by *C. A. White*