


T. 13S. R. 33 & 34E. W.M.

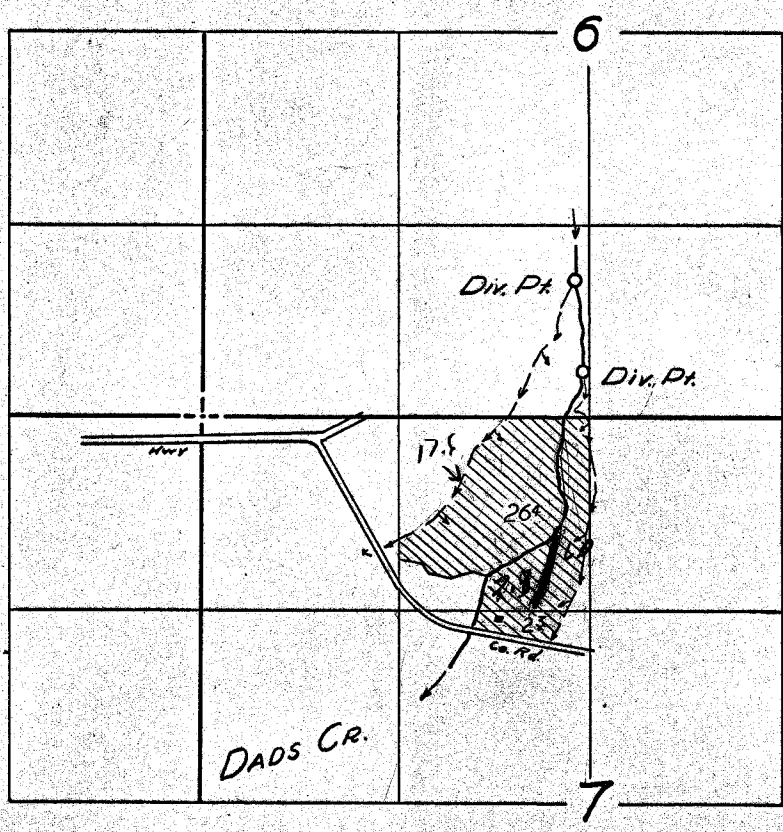

FINAL PROOF SURVEY
UNDER

Application No. 23818 Permit No. 19432

IN NAME OF

WAYNE HYDE

Surveyed 31 Oct. 1956, by [Signature]