


T. 5S. R. 1E. W.M.

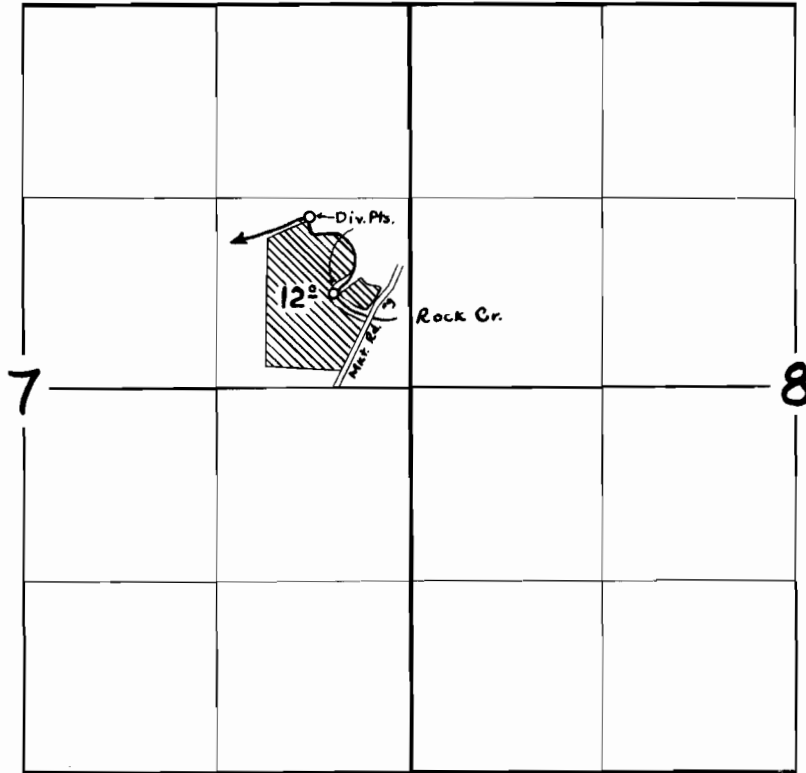

FINAL PROOF SURVEY

UNDER

Application No. 24531 Permit No. 19460

IN NAME OF

Halvor H. Gregerson

Surveyed 7 Mar. 1956, by R. D. Best