


T.28 S. R.6 W. W.M.

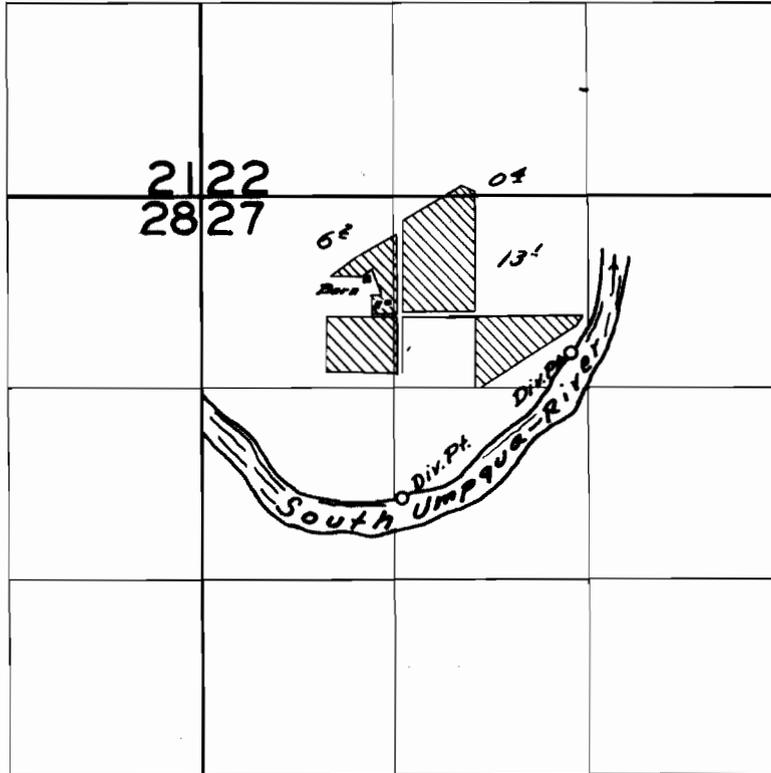

FINAL PROOF SURVEY
UNDER

Application No. 24663 Permit No. 19477
IN NAME OF

George P. & Maude H. Powers

Surveyed Aug. 1 1956, by C. O. Baile