


T. 5N R. 4W W.M.

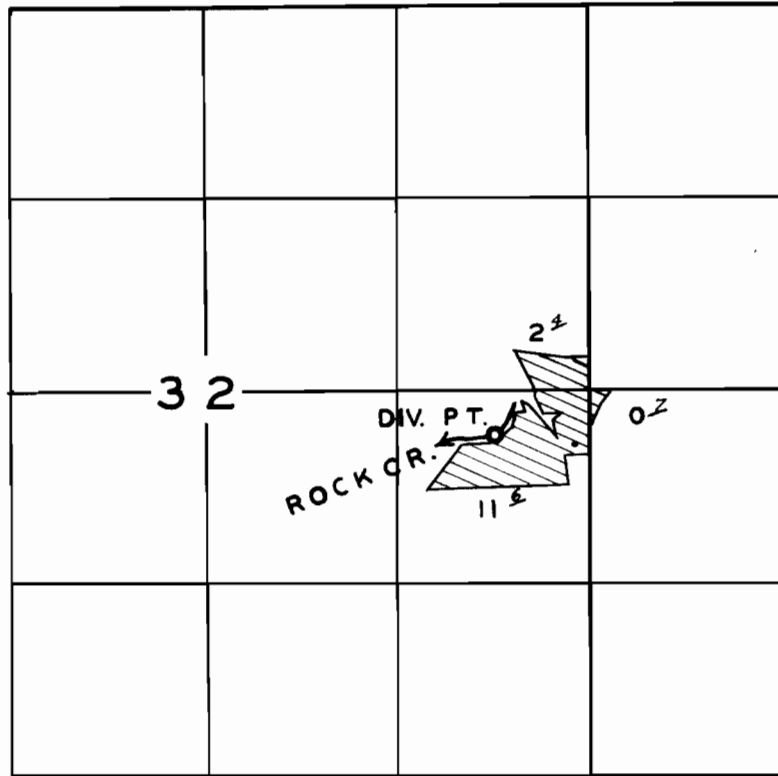

FINAL PROOF SURVEY

UNDER

Application No. ~~24698~~ Permit No. ~~19491~~.....

IN NAME OF

JAMES P. MCFARLAND

Surveyed SEPT. 9 1956, by R. H. WHITBY.

1956 V
R.H.W.