


T. 11 S. R. 6 W. W. M.

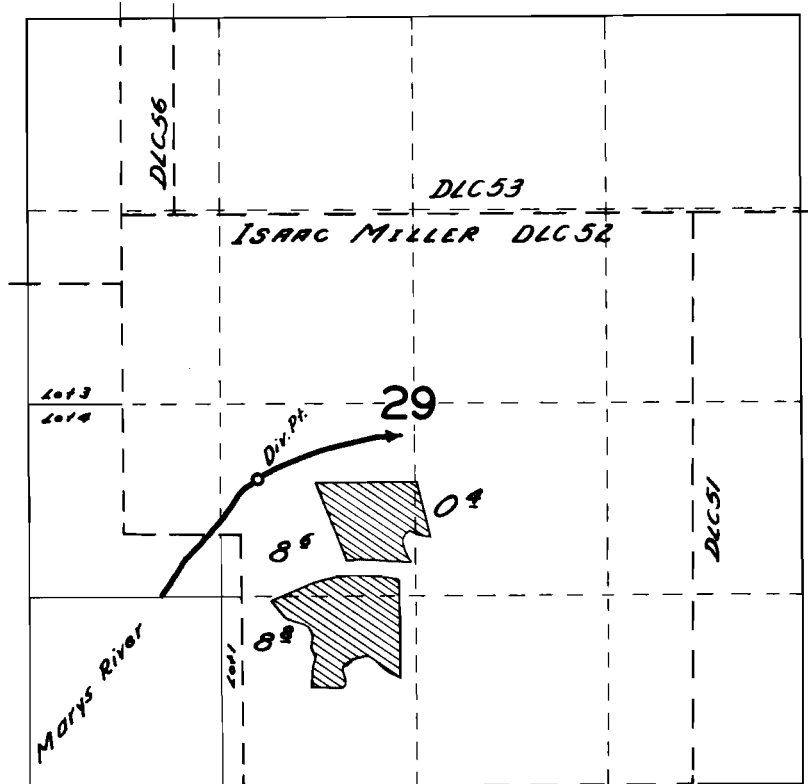

FINAL PROOF SURVEY

UNDER

Application No. 24719 Permit No. 19497

IN NAME OF

.....H. C. TAYLOR.....

Surveyed Aug. 17 1956, by C. O. Bartels.....