T. 9S. R. 5W. W.M.

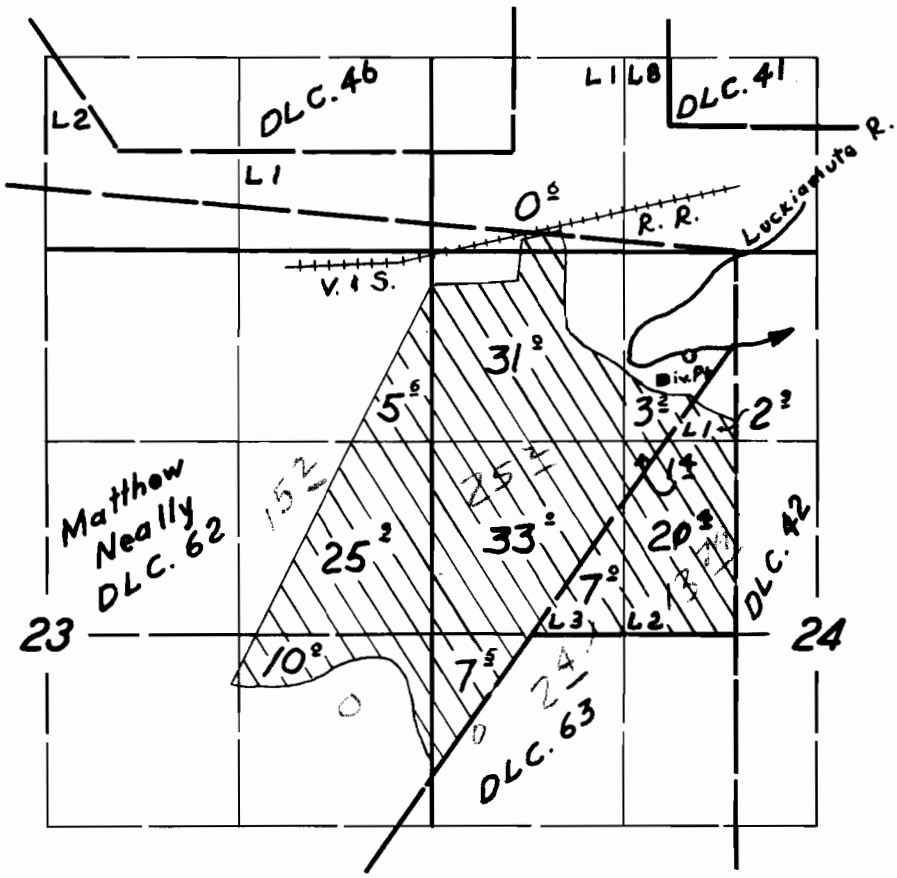

FINAL PROOF SURVEY

UNDER

Application No. 24325 Permit No. 19640

IN NAME OF

E. H. LORENCE

Surveyed 15 Aug. 1956, by R. H. Whitby

OFP-20-126