


T.5 S.R.1W.W.M.

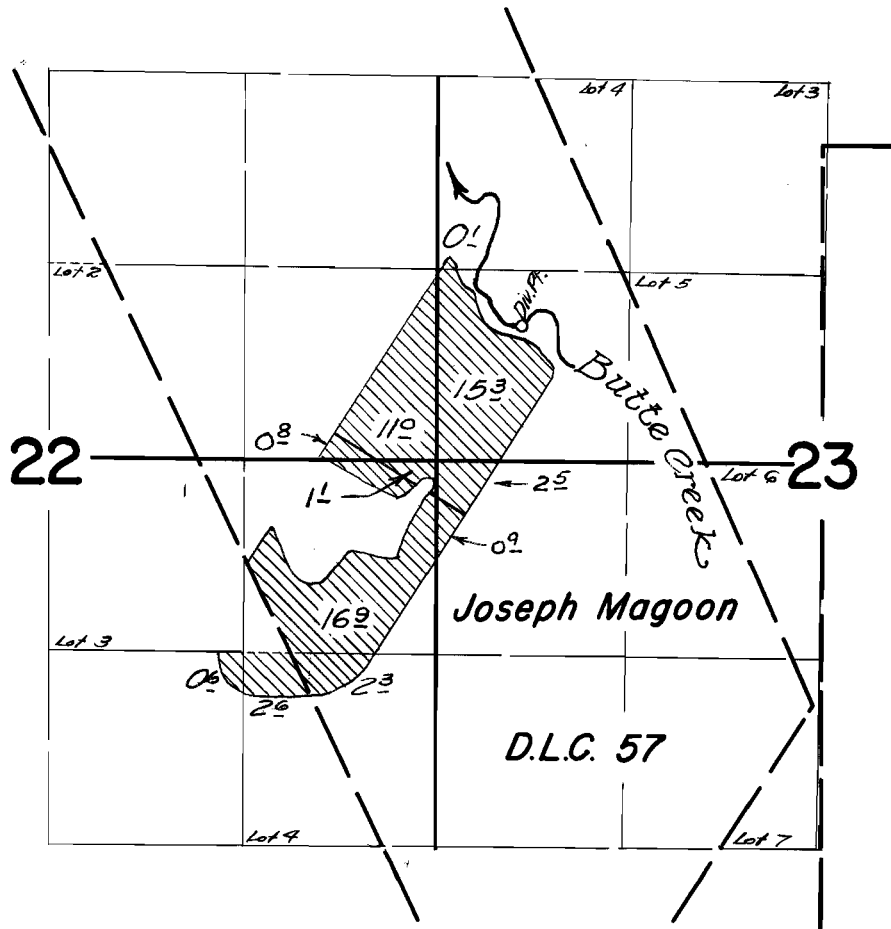

FINAL PROOF SURVEY
UNDER

42235 31582
Application No. **24481** Permit No. **19646**
IN NAME OF

JOSEPH SCHAEFER % ALVIN SCHAEFER

Surveyed Feb. 29 1956, by R.D. Best.