


T. 3S. R. 1W. W.M.

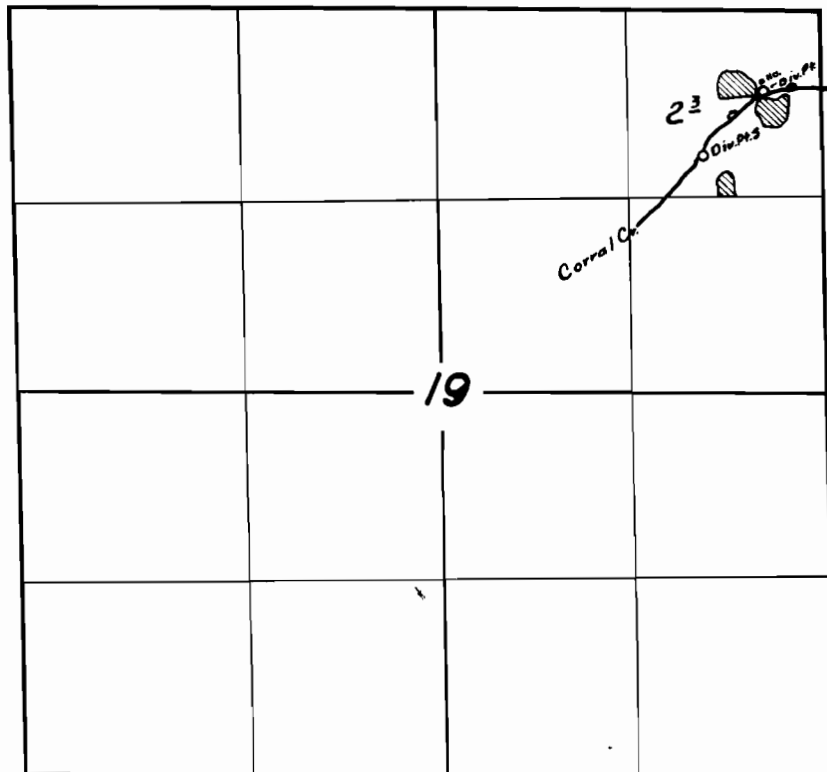

FINAL PROOF SURVEY
UNDER

Application No. 24543 Permit No. 19647
IN NAME OF

RALPH C. O'MEALY

Surveyed 16 May 1956, by M. Bish

DFK-2D-45

RBH