


T. 6 N. R. 4 W. W. M.

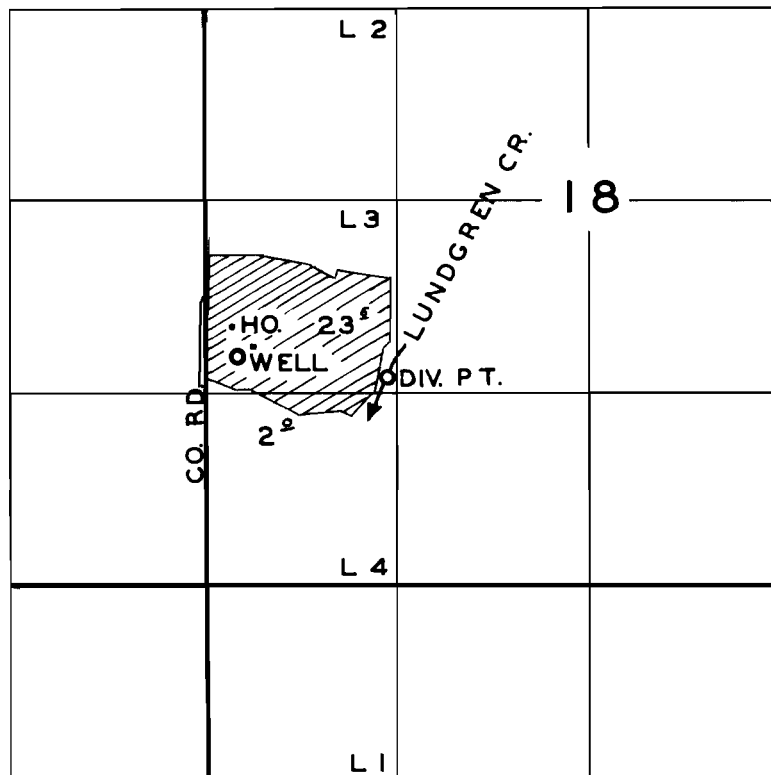

FINAL PROOF SURVEY
UNDER

Application No. 2 4882 Permit No. 19679

IN NAME OF

J. E. CRAWFORD

Surveyed AUG. 29 1956, by R. H. WHITBY

1956 V
L. W. J.