


T.25S. R.6 W.W.M.

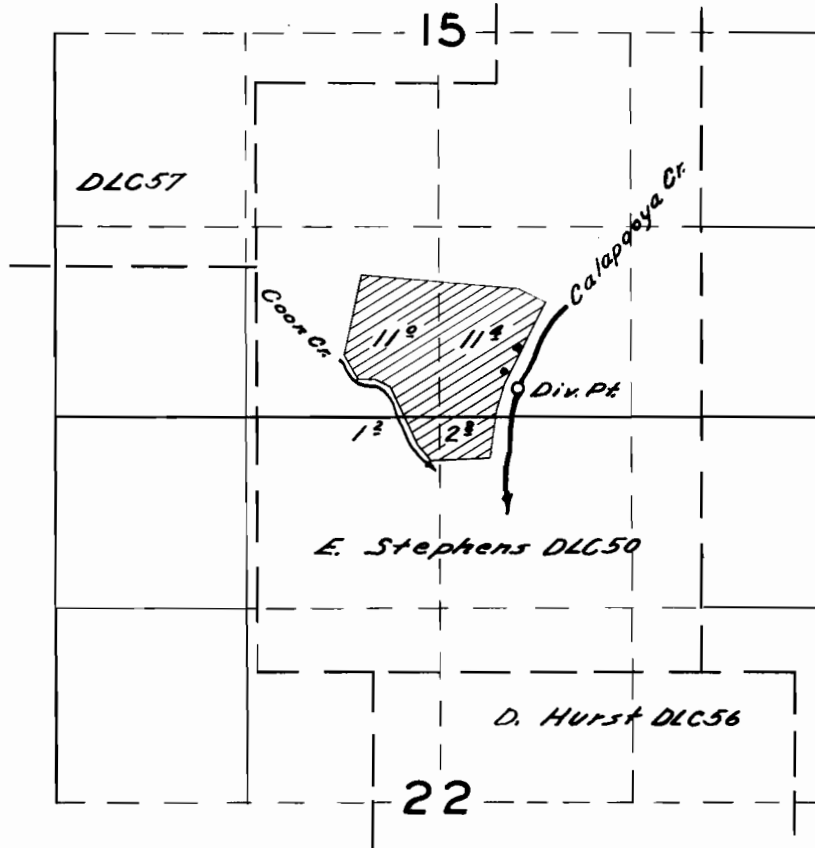

FINAL PROOF SURVEY

UNDER

Application No. *25088* Permit No. *19747*...

IN NAME OF

.....*Walter R. Davis*.....

Surveyed *Aug. 22* 1956., by *C. O. Bartels*..