


T. 4 S. R. 1 W. W. M.

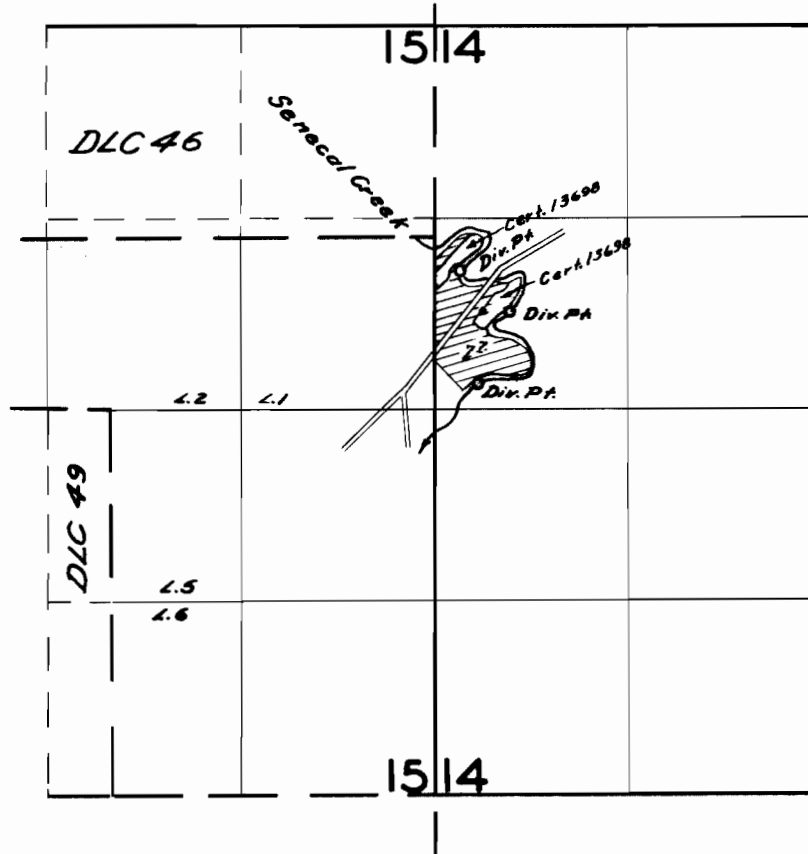

**FINAL PROOF SURVEY**  
UNDER

Application No. 25314 Permit No. 19865  
IN NAME OF

Howard Keil

Surveyed June 1 1956, by G. O. Bartels