


T. 4 N R. 5 W W.M.

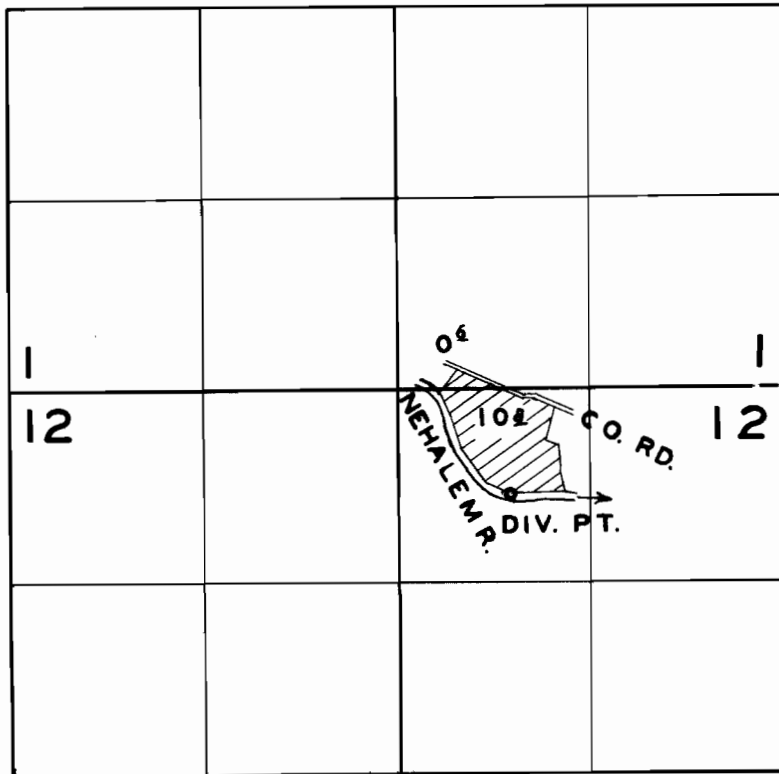

FINAL PROOF SURVEY
UNDER

Application No. 25226 Permit No. 19960
IN NAME OF

CECIL HUFF

Surveyed SEPT. 11 1956, by R. H. WHITBY