


T. 4 N. R. 1 W. W. M.

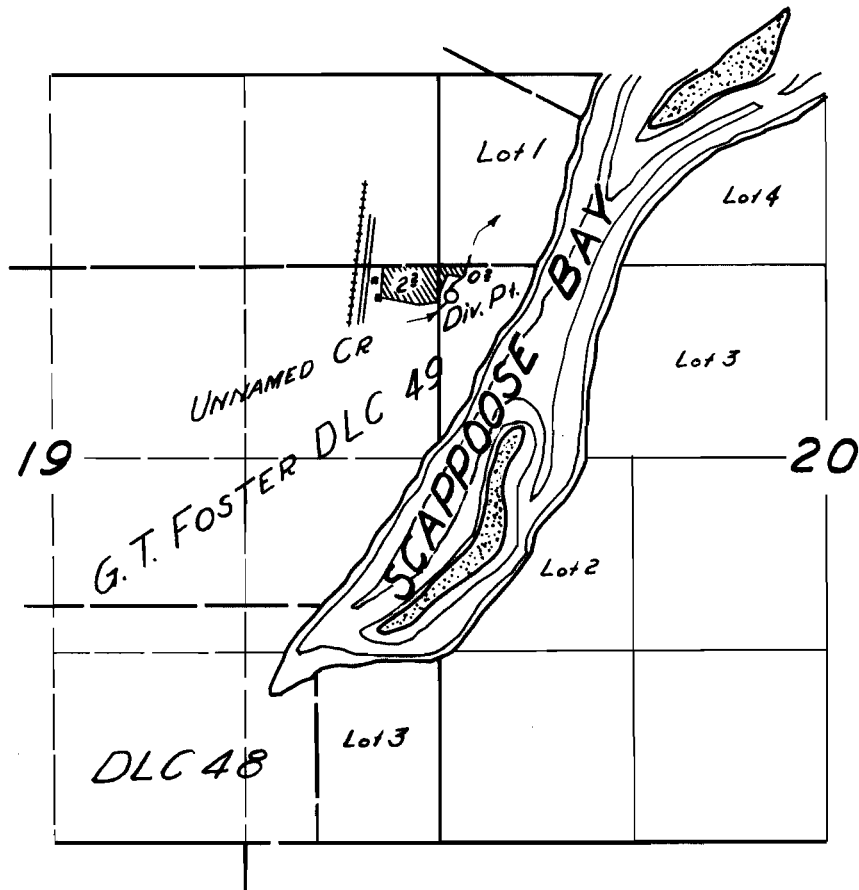

**FINAL PROOF SURVEY**  
UNDER

Application No. 25313 Permit No. 19975

IN NAME OF

J. E. BEELER

Surveyed 11 July 1956, by [Signature]