


T1&2S R9WWM

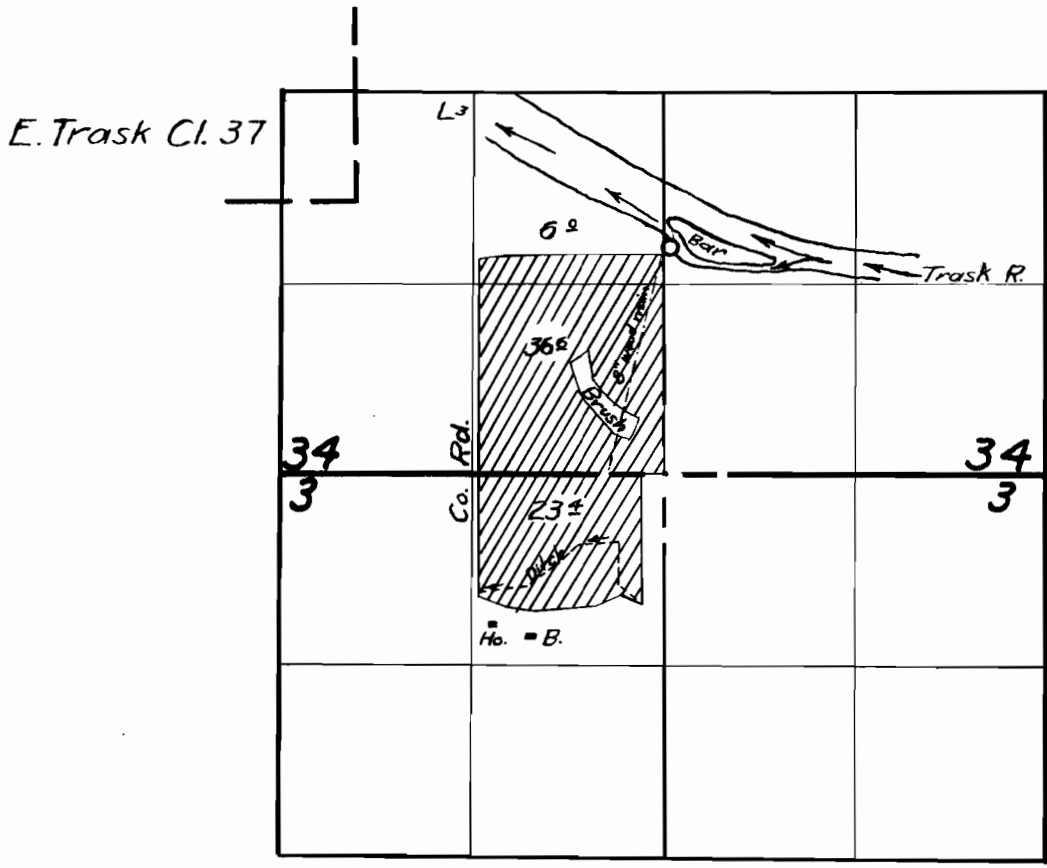

FINAL PROOF SURVEY

UNDER

Application No. *25655* Permit No. *20120*
IN NAME OF

Estate of Gus Goeres

Surveyed *July 21*, 1955, by *M. Bish*

SURVEYOR'S CERTIFICATE

I, W.E. Anderson, County Surveyor of Tillamook Ore, do hereby certify that this map was made from notes taken during an actual survey made by me in Jan. 1951, and that the monuments shown on this map have the co-ordinates shown from the Sec corner

To - 3 - 4 - 33 - 34 T. 2. S. R. 9. W. W. 11
Co. Surv. W.E. Anderson

N 1644.5
E 323
2' I.P.

Ed Weston
LANE

N 1522.7
E 100.1
2' I.P.
D. Kennedy

6.0 ACRES

8' Main 1090' buried

GUS GOERES 57' 47" Sec

40 ACRES

N 00
E 00
1 1/2" I.P.

1/4 COR

33

34

4

3

Application No. 25655
Permit No. 20120

COUNTY ROAD

RIVER BOTTOM

25 ACRES

HILL LAND

RECEIVED

MAR 6 1951

STATE ENGINEER
SALEM, OREGON

COUNTY ROAD

GUS GOERES WATER RIGHT
LOCATED

IN SEC 3-34 TWP 2. S. R. 9. W. W. 11
TILLAMOOK ORE
Scale = 400'

RECEIVED

FEB 16 1951

STATE ENGINEER
SALEM, OREGON

15825

25655-1-19