


T. 5 S. R. 5 W. W.M.

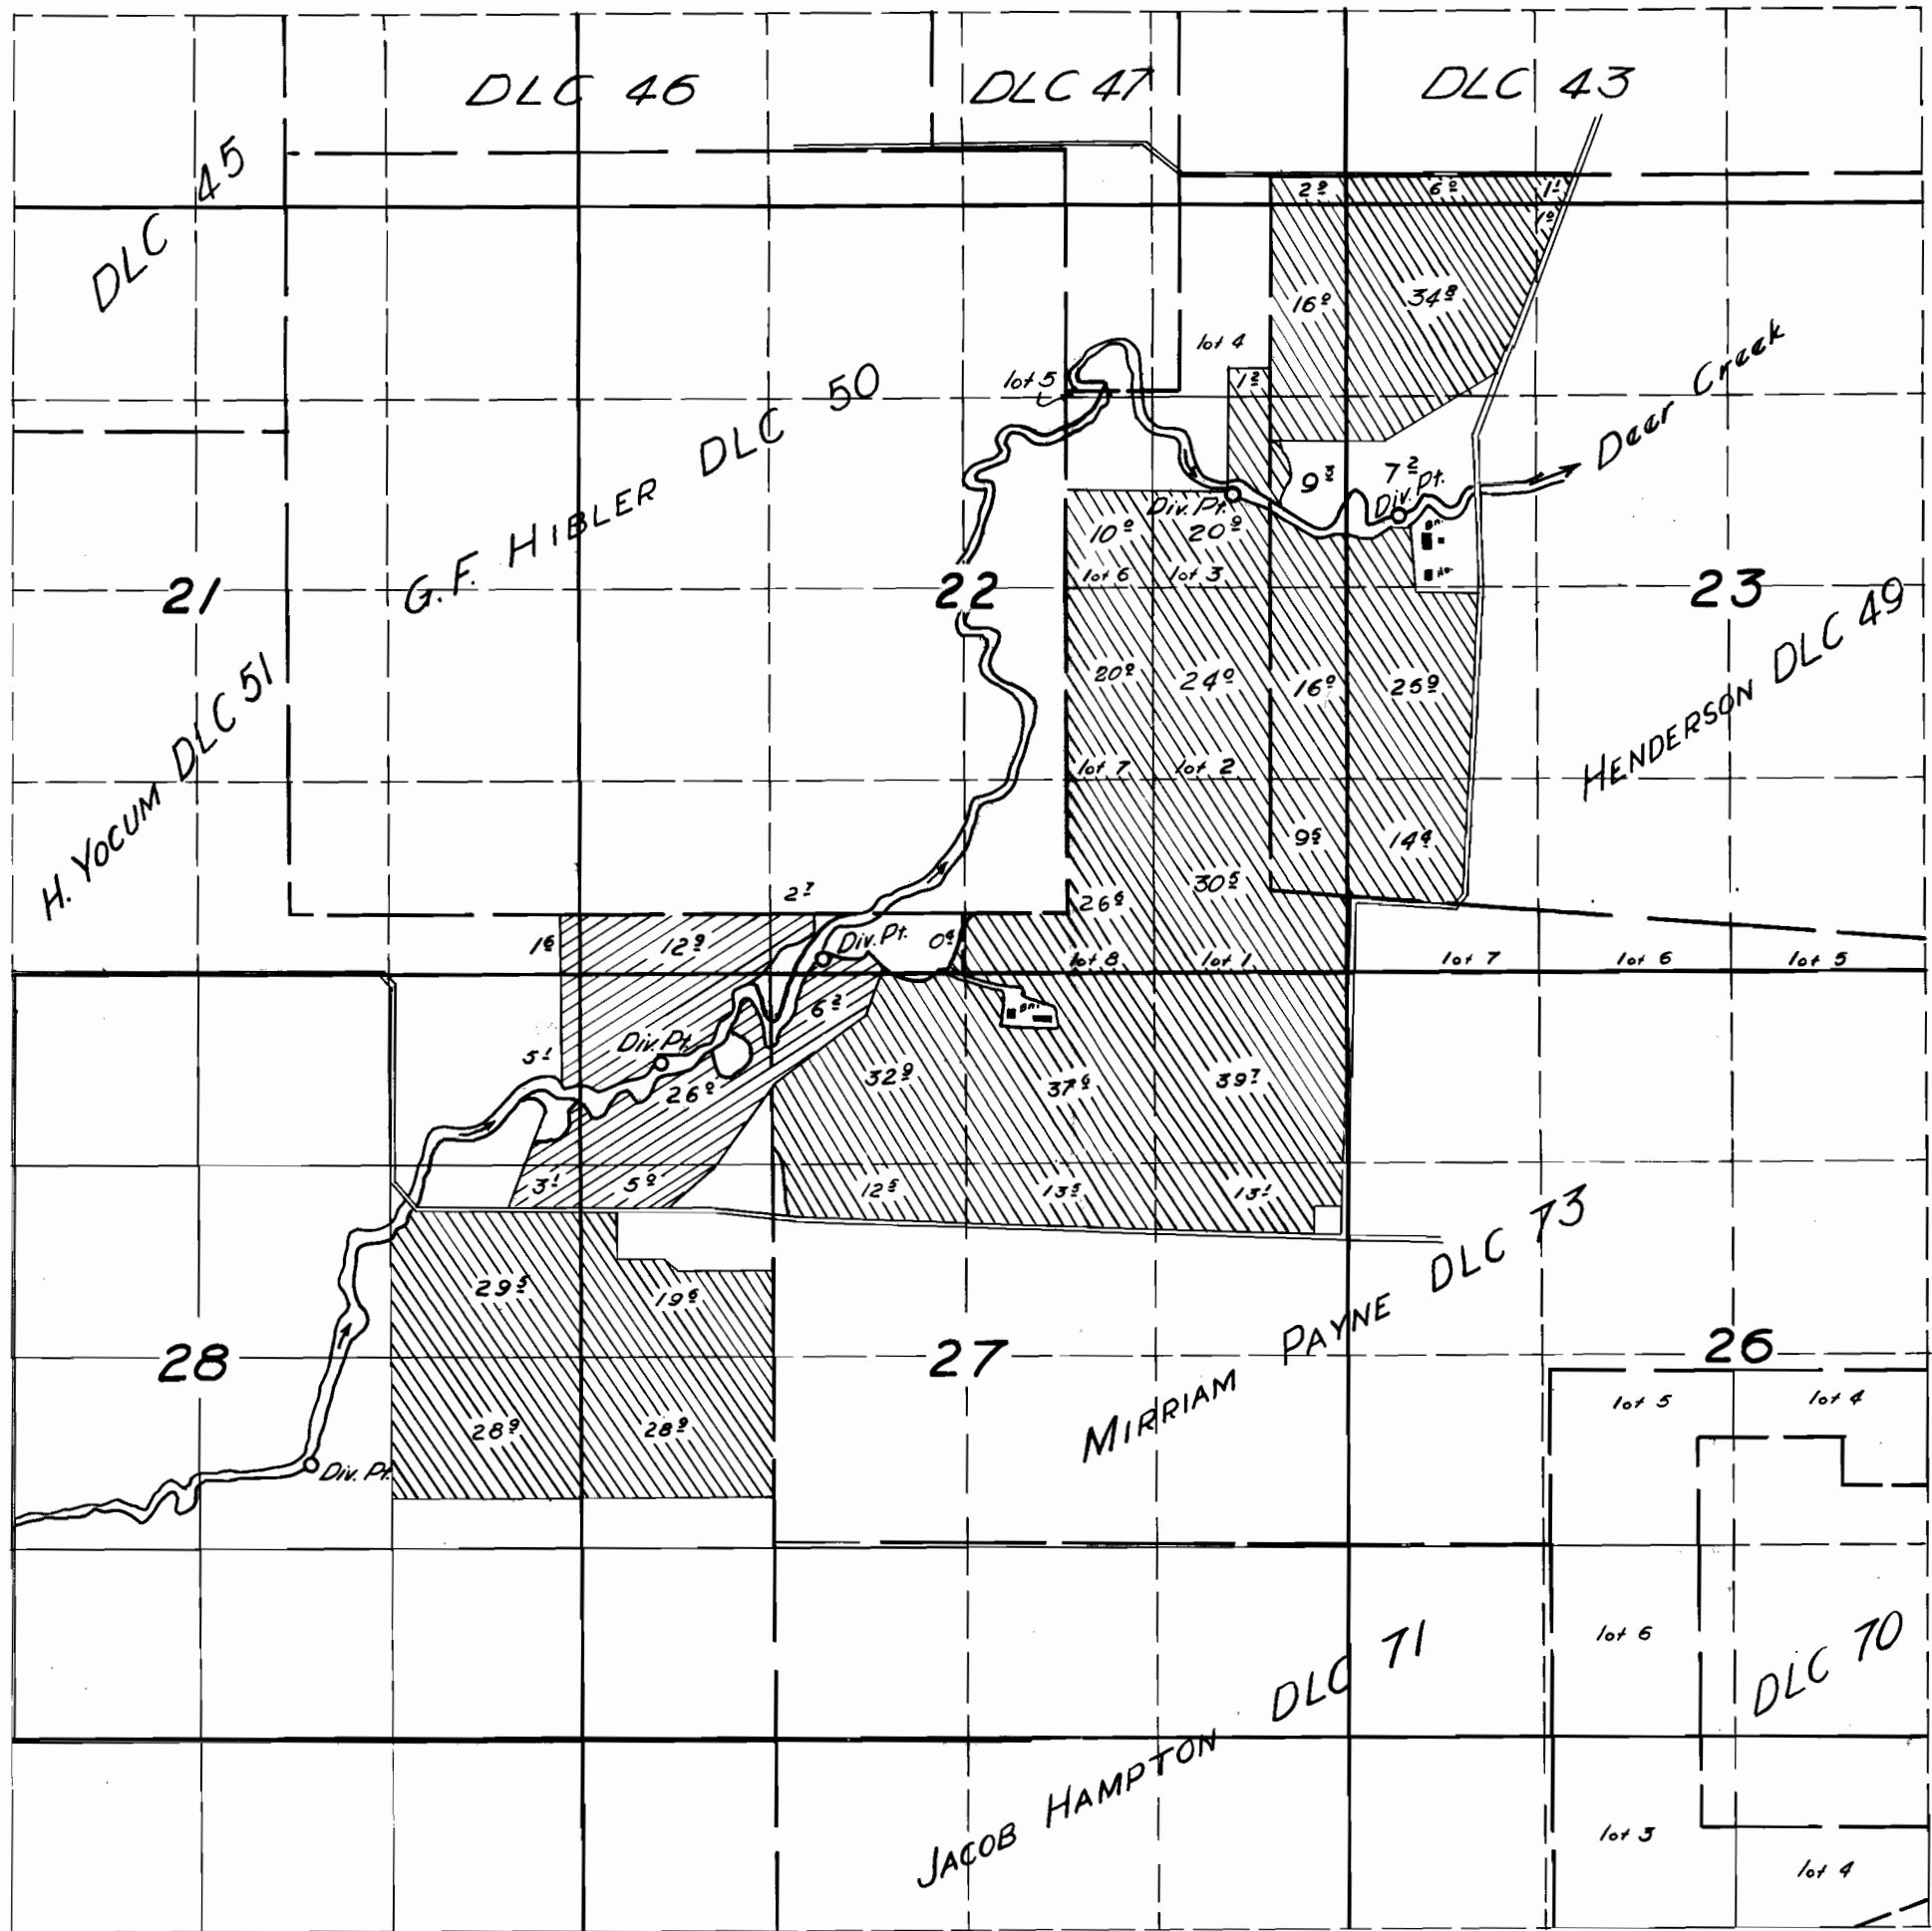

**WATER RIGHT
FINAL PROOF SURVEY**
Under

Application Nos. 25625 & 25737

Permit Nos. 20103 & 20147

In Name of

BELLEVUE FARMS

Surveyed 22 Mar 1956

by *R. Whitley*