


T. 6 N. R. 5 W. W. M.

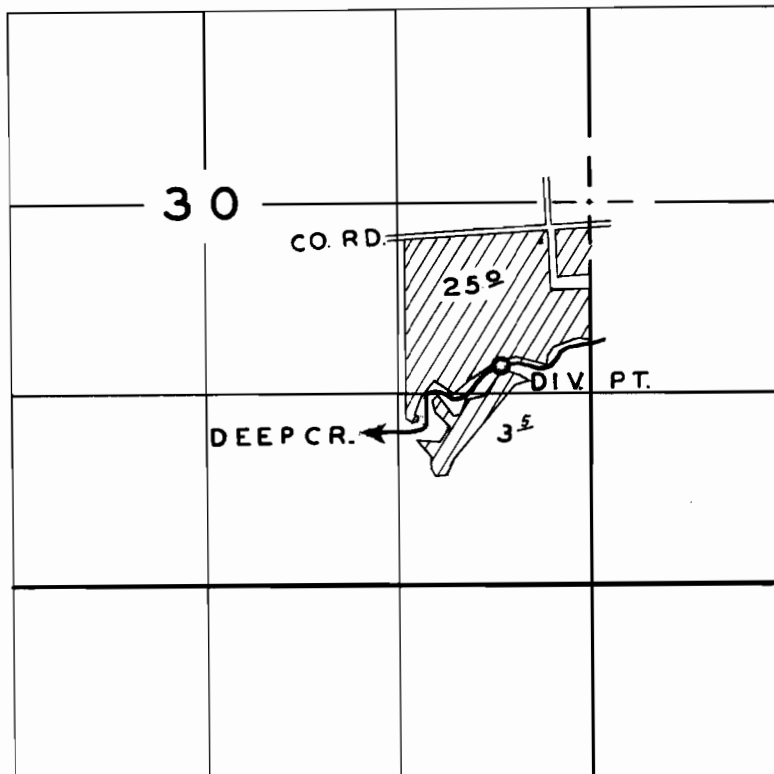

FINAL PROOF SURVEY
UNDER

Application No. 25583... Permit No. 20169....
IN NAME OF

M. PIERRE MILLS

Surveyed AUG. 31, 1956, by R. H. WHITBY....