


T.22S. R. 4W.W.M.

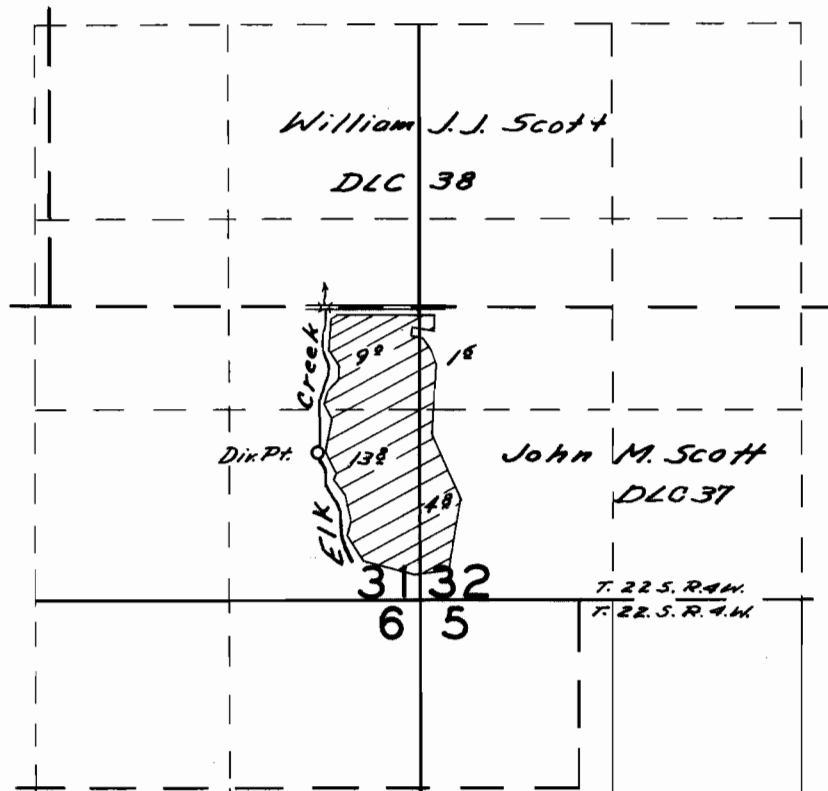

FINAL PROOF SURVEY

UNDER

Application No. 25660 Permit No. 20237
IN NAME OF

Harold Turpin

Surveyed July 2 1956, by C.O. Bartels