


T3S.R.2E.W.M.

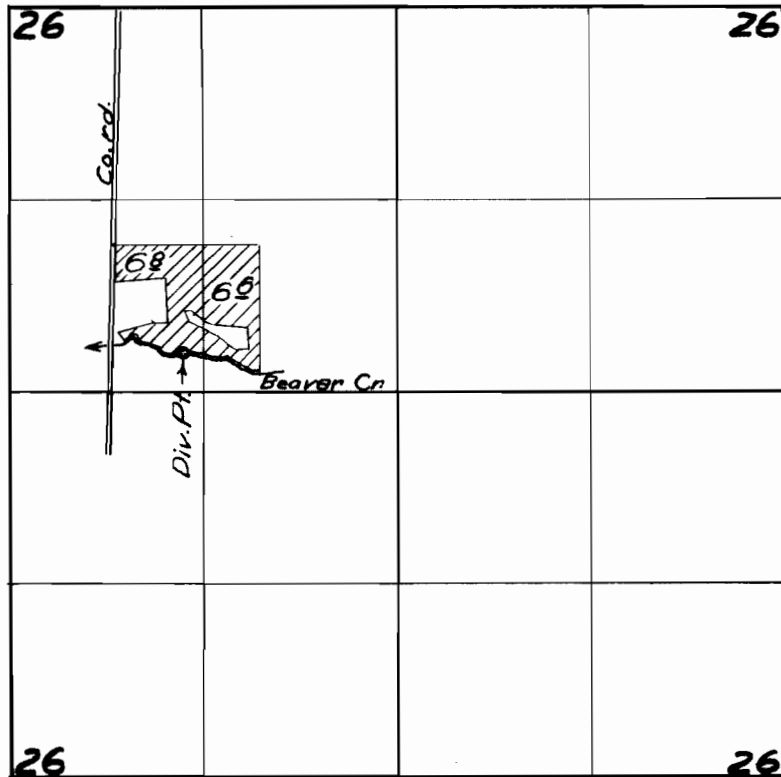

FINAL PROOF SURVEY

UNDER

Application No. 25937 Permit No. 20340

IN NAME OF

Earl W. Robinson

Surveyed 28 Aug 1956, by Tom Bish