


T.22S. R.4W.W.M.

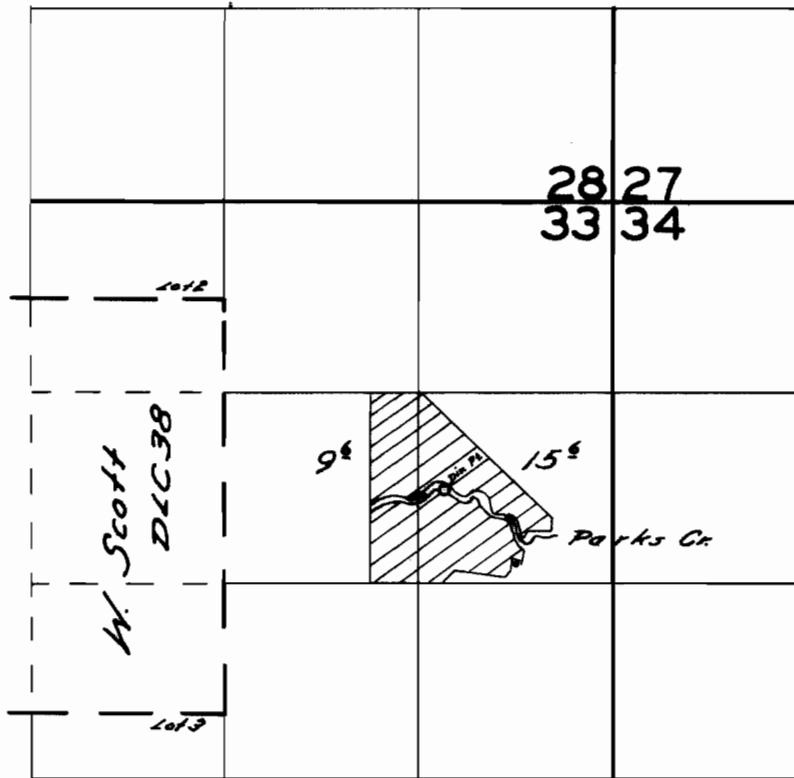

**FINAL PROOF SURVEY**

UNDER

Application No. 25965 Permit No. 20353

IN NAME OF

.....Peter F. Luby.....

Surveyed July 13 1956, by C.O. Bartels