


, Range 24 E.W.M.

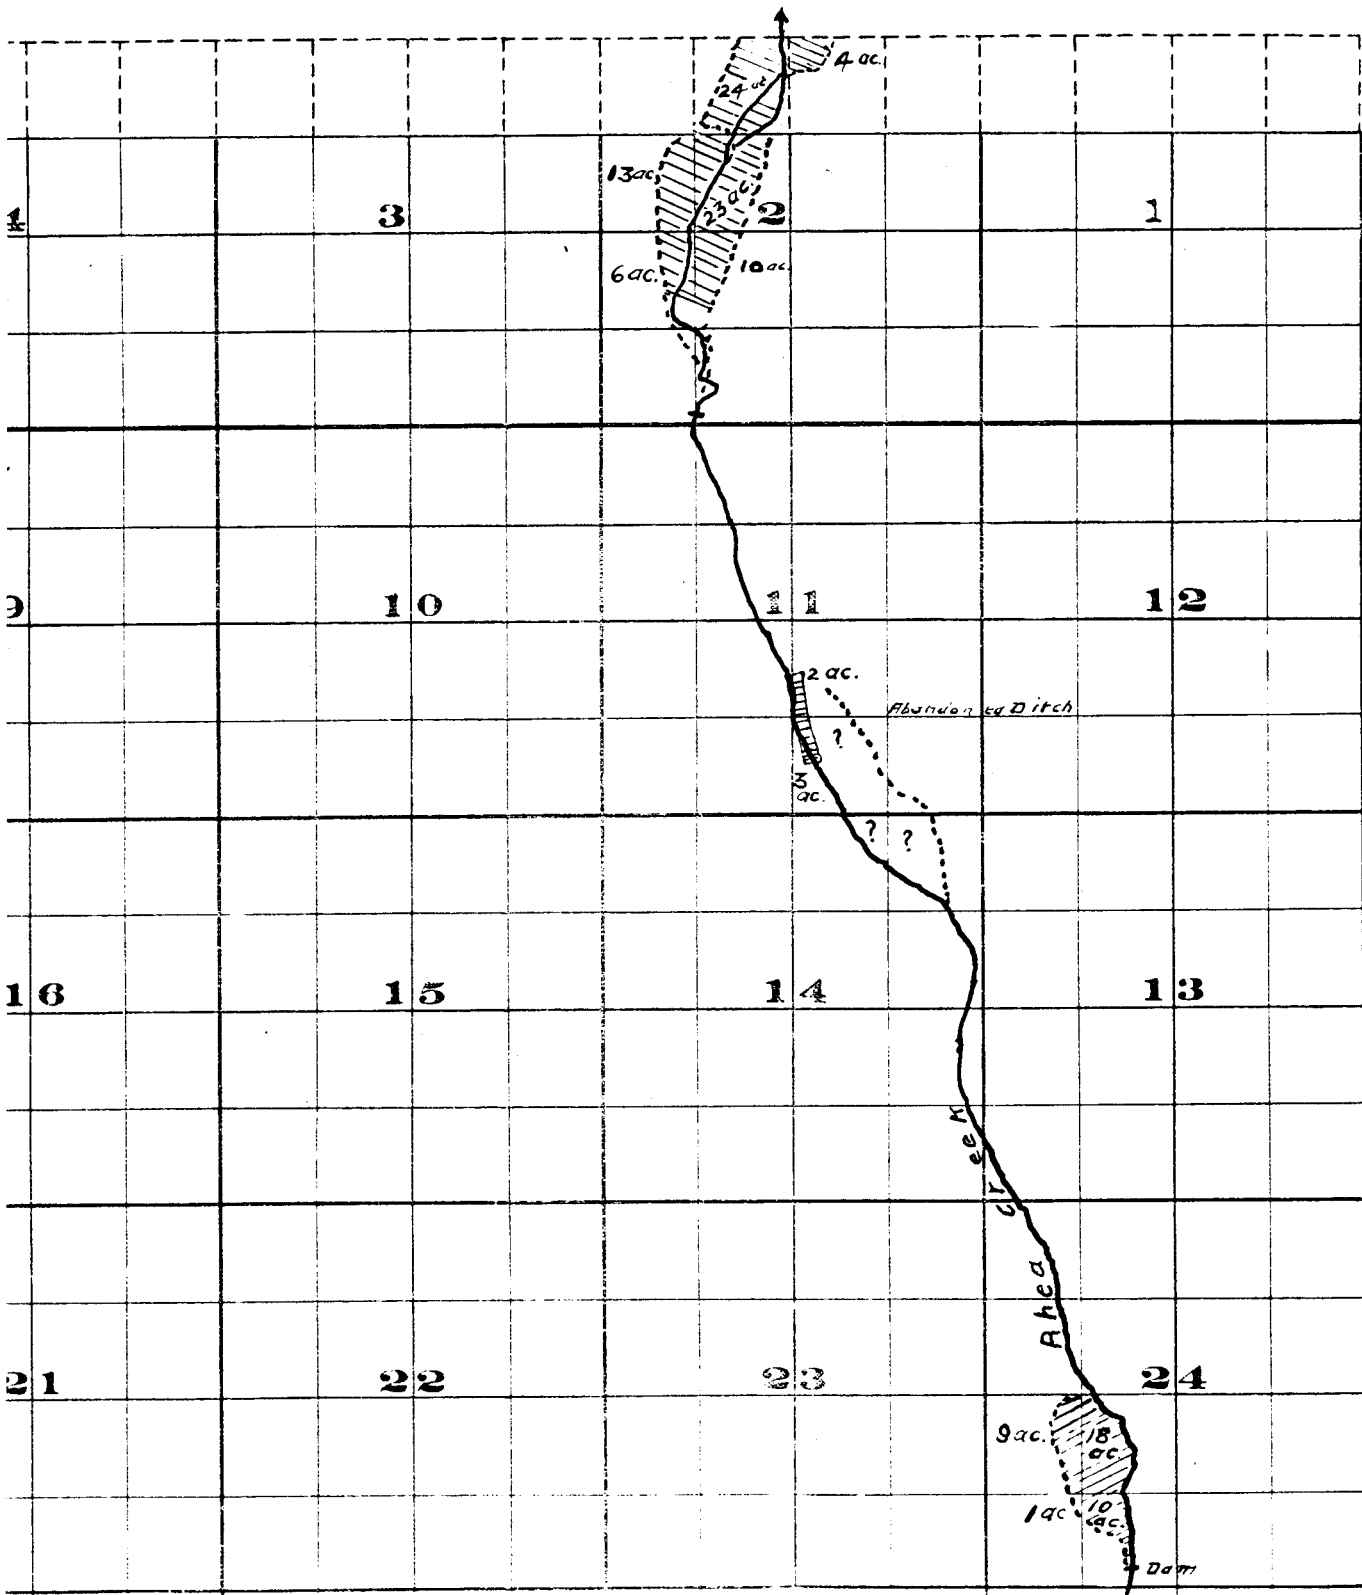

,

[illegible]


7			8			9			10
18			17			16			15
19			20			21			22
30			29			28			27
31			32			33			34


Surveyed by R.D. Cooper July 1909

John H. Lewis - State Engineer.

Examined July 14, 1909

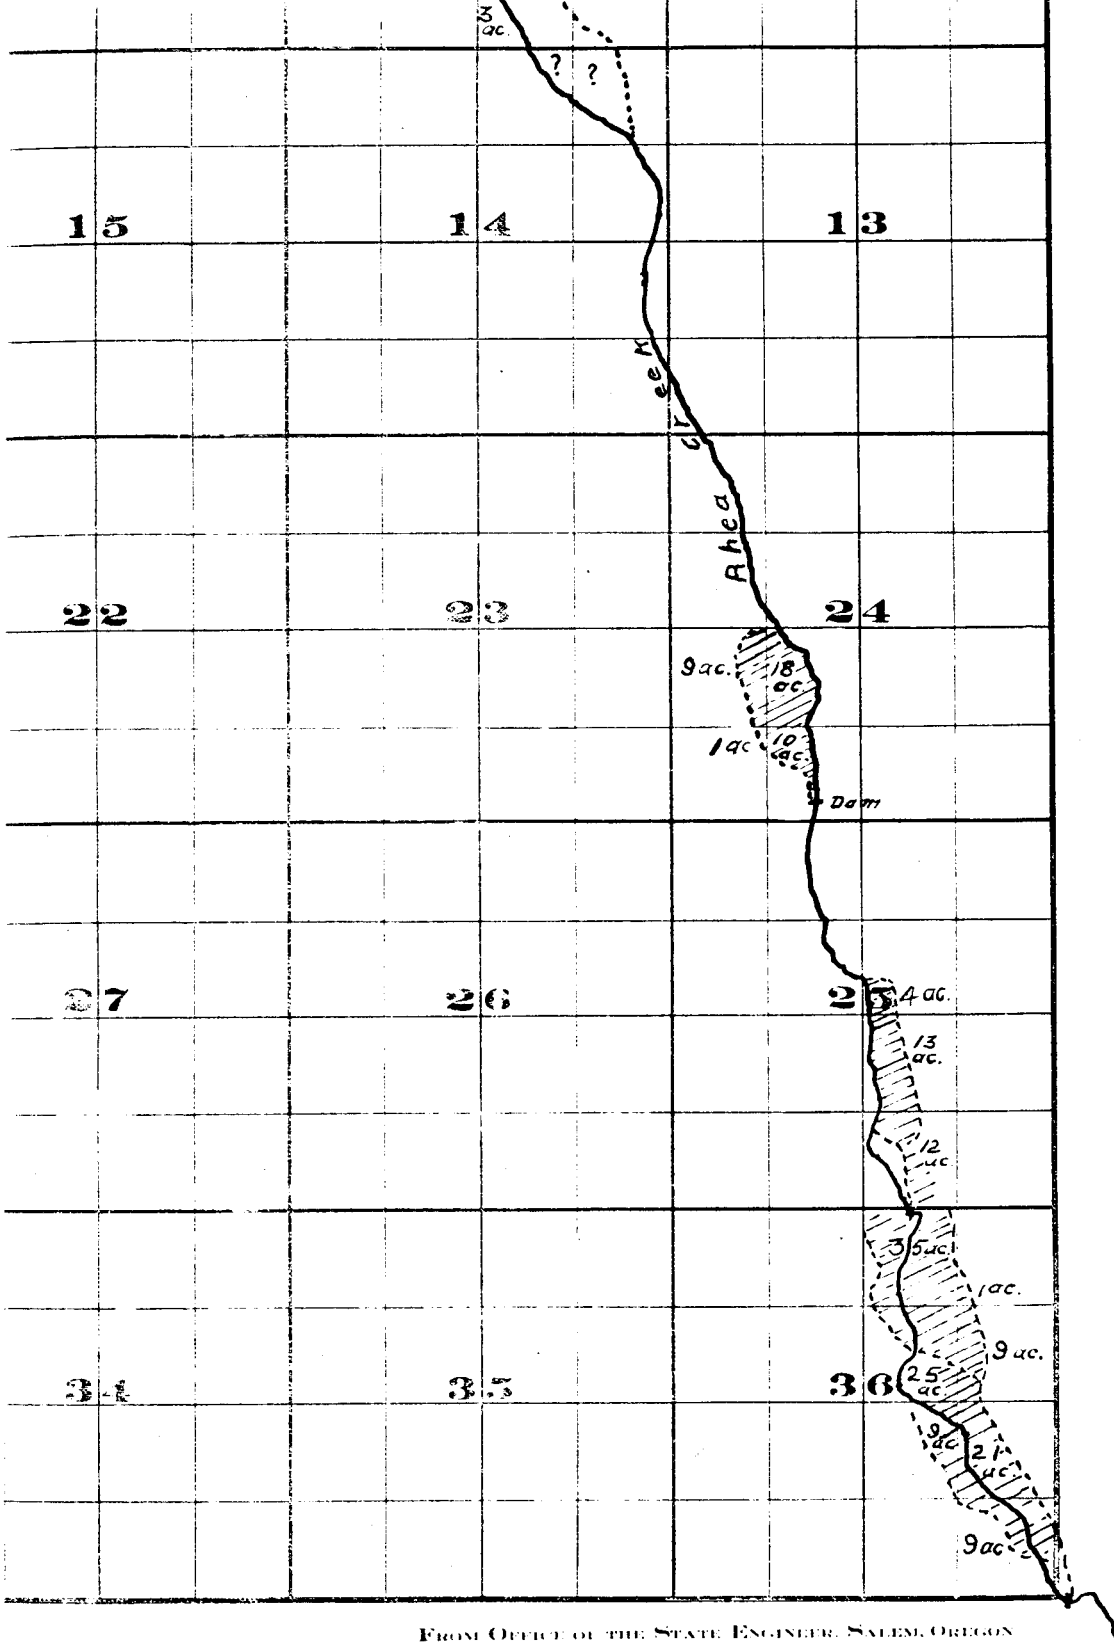

FROM OFFICE OF THE STATE ENGINEER, SALEM, OREGON

Willow Creek Adjudication.

2 S. 24 E.