


T.3 S. R. 3E.W.M.

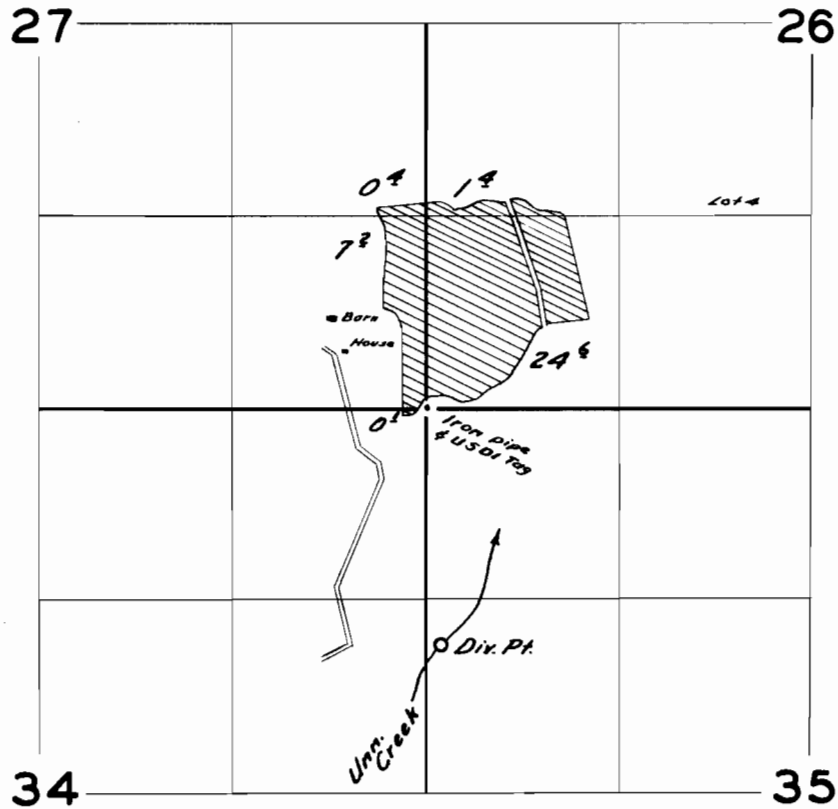

FINAL PROOF SURVEY
UNDER

Application No. 26167 Permit No. 20925
IN NAME OF

J. P. Lausen

Surveyed Sept. 24 1956, by C. O. Bartels