


T.22S, R. 6W.W.M.

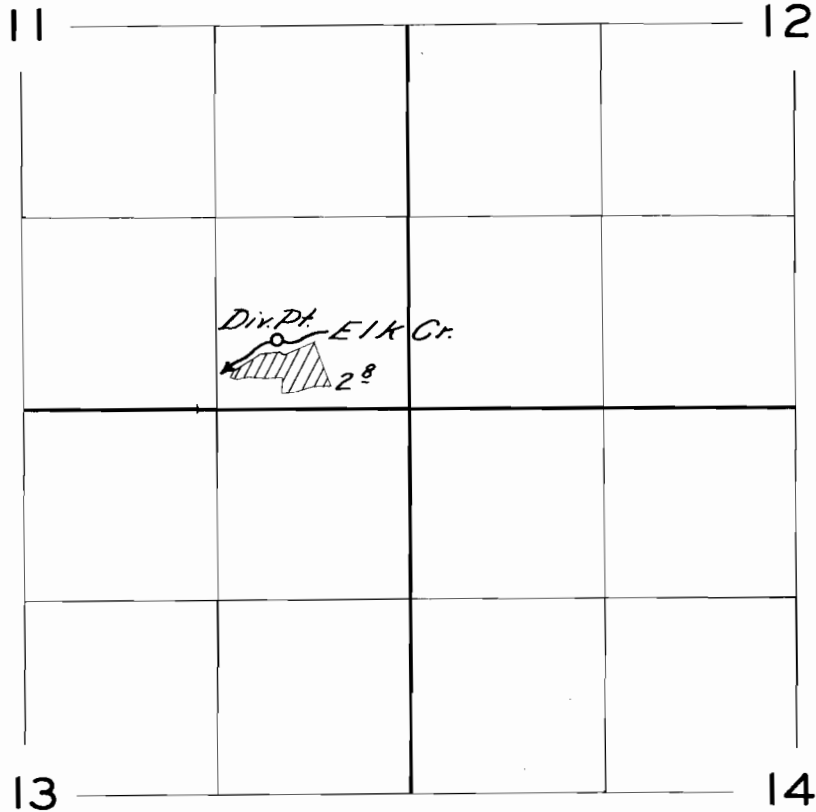

**SUBJECT PROOF SURVEY**  
UNDER

Application No. 26216 Permit No. 20600  
IN NAME OF

*Roy M. Jones*

Surveyed June 28 1956, by *C. O. Bartels*