


T. 13 S. R. 33 & 34 E. W. M.

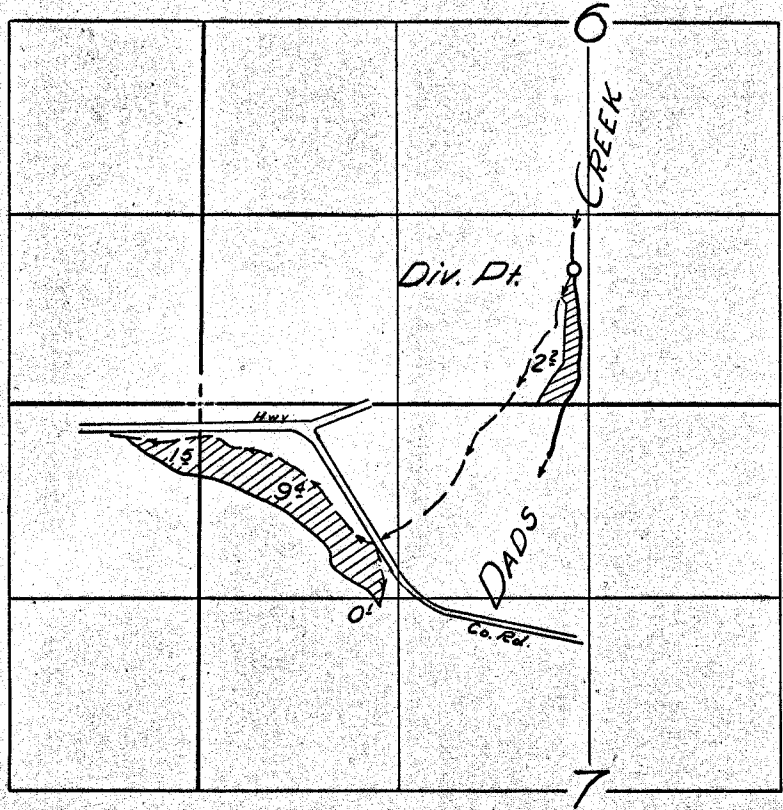

**FINAL PROOF SURVEY**

UNDER

Application No. <sup>26559</sup>~~26699~~ Permit No. 20810

IN NAME OF

ORRIN FORREST

Surveyed 31 Oct. 1956, by [Signature]