


T. 29S. R. 4W. W.M

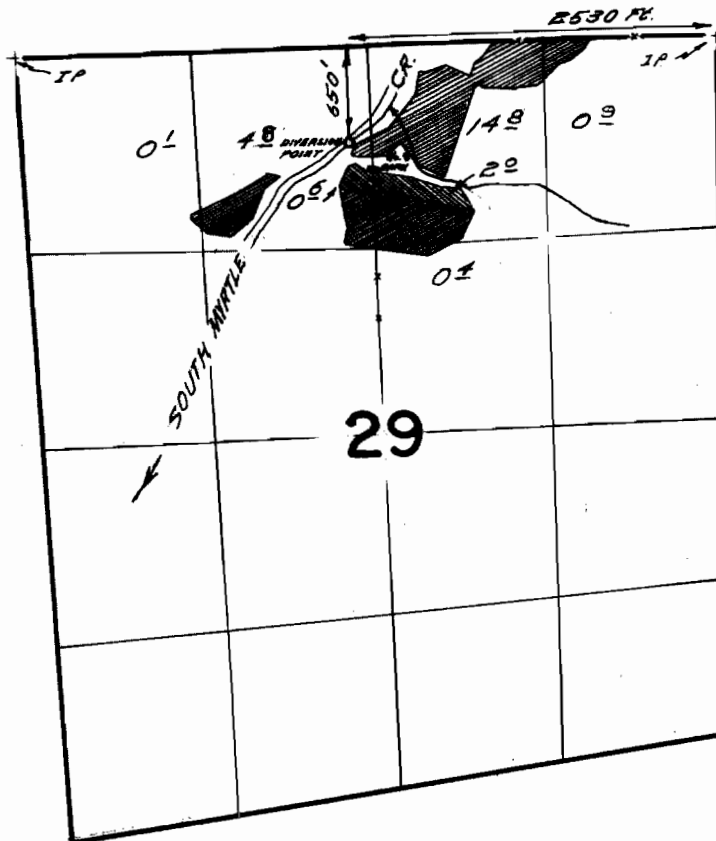

 PRIMARY

 CERT. # 19463

FINAL PROOF SURVEY UNDER

Application No. 26852 Permit No. 21088...
IN NAME OF

.....*WILLIAM E. WILLIAMS*.....

Surveyed *Sept. 25, 1956*, by *F. H. Whitby*...
June 27, 1968 by *W. C. Ruppert*