


T. 11 S. R. 4 W. W. M.

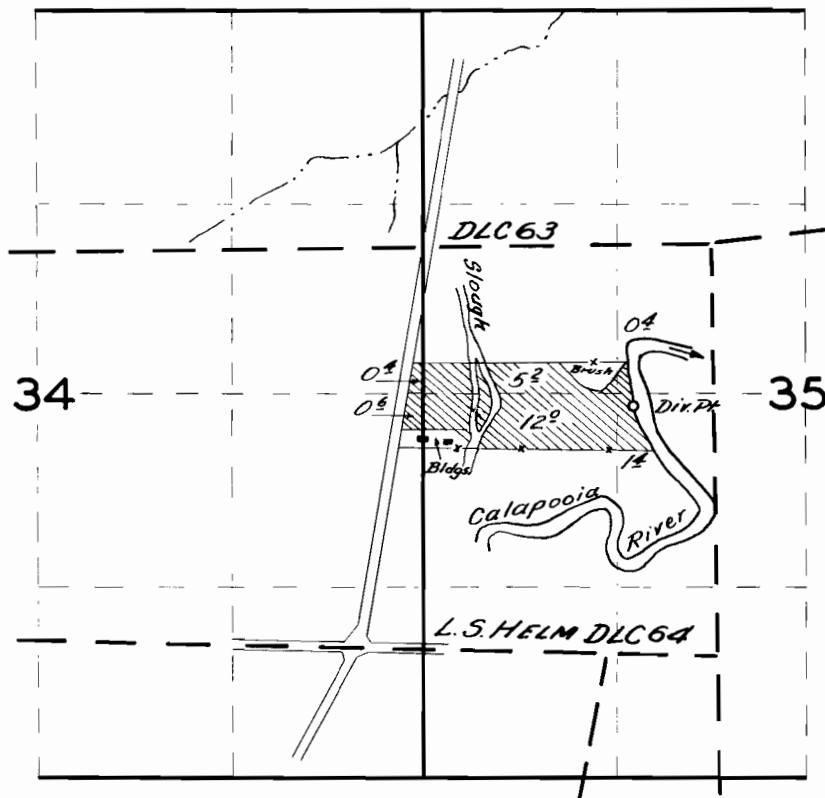

FINAL PROOF SURVEY

UNDER

Application No. 26944 Permit No. 21169

IN NAME OF

Michael G. Owen Jr. & Lois S. Owen

Surveyed July 24 1956, by *R.H. Whitby*

DFM-5D-32