


T. 3 N. R. 2 W. W.M.

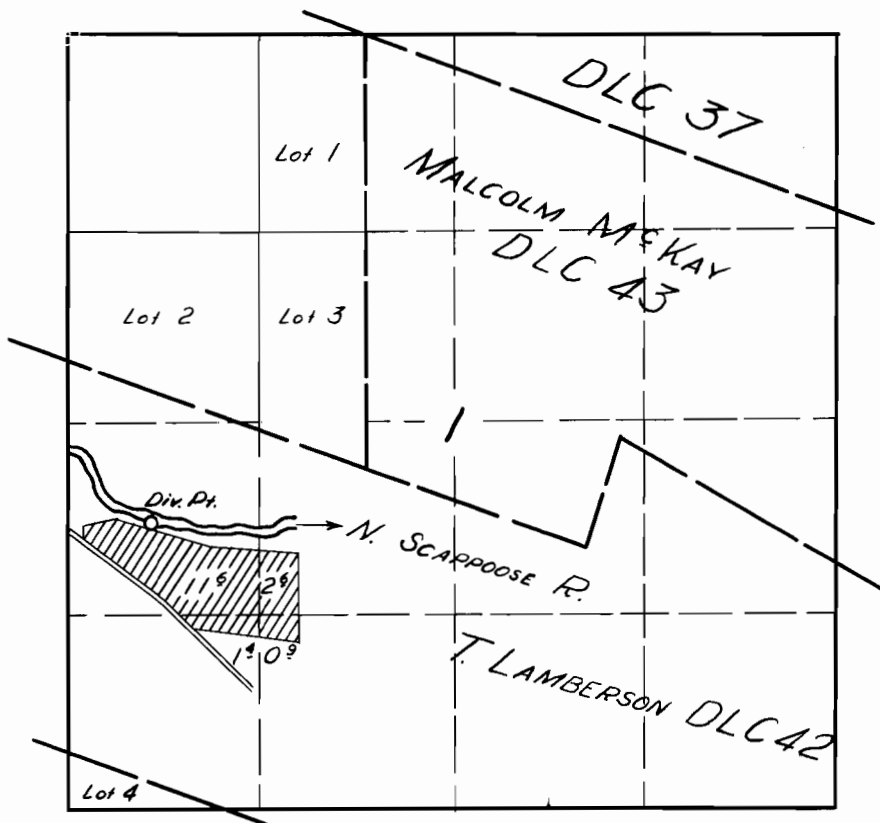

FINAL PROOF SURVEY

UNDER

Application No. 27068 Permit No. 21298

IN NAME OF

DUANE JONES

Surveyed 5 Aug. 1956, by [Signature]