


T. 9 S. R. 2 W. W. M.

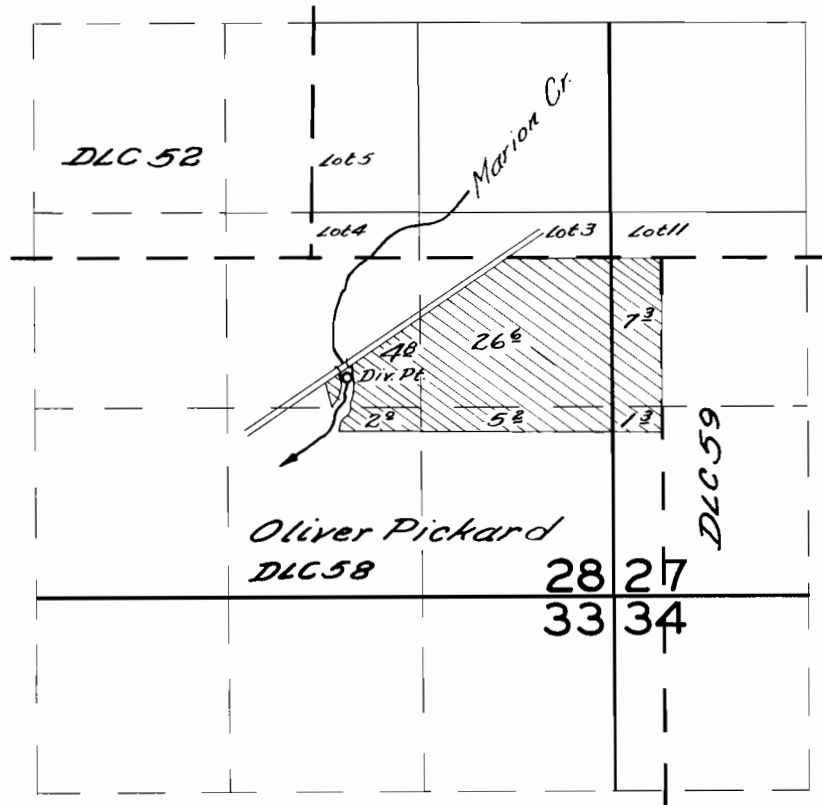

FINAL PROOF SURVEY
UNDER

Application No. *27175* Permit No. *21371*
IN NAME OF

GOTTFRIED SCHELSKE

Surveyed *May 15* 1956, by *R.H. Whitby*.

DFN-2D-52