


T. 6 S. R. 3 W. W. M.

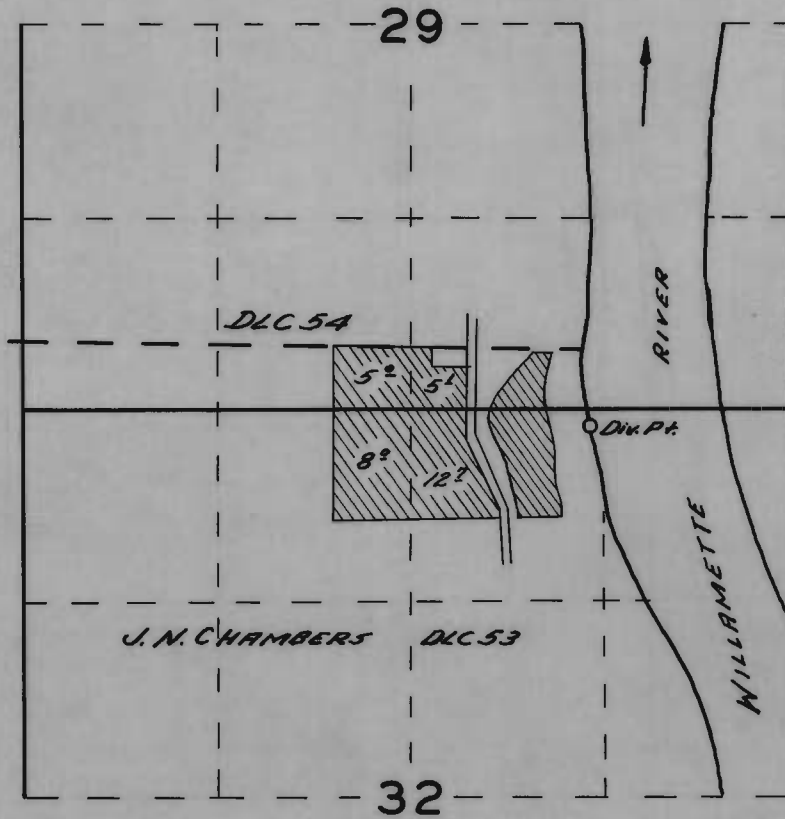

**FINAL PROOF SURVEY**

UNDER

Application No. 25408 Permit No. 21504

IN NAME OF

LAWRENCE J. MICKEY

Surveyed Sept. 28, 1956, by C.O. Bartels