


T. 10 S. R. 2 W. W. M.

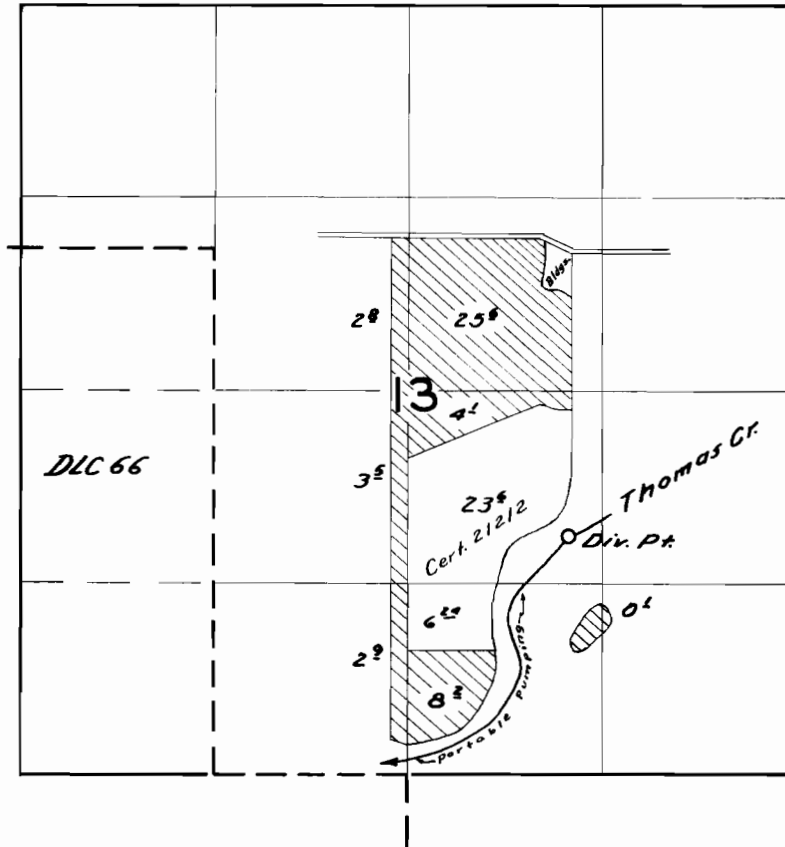

**FINAL PROOF SURVEY**

UNDER

Application No. *27404* Permit No. *21582*  
IN NAME OF

*HENRY & IVA NOVAK*

Surveyed *July 25, 1956*, by *C.O. Bartels*