


T. 6 & 7 N. R. 5 W. W. M.

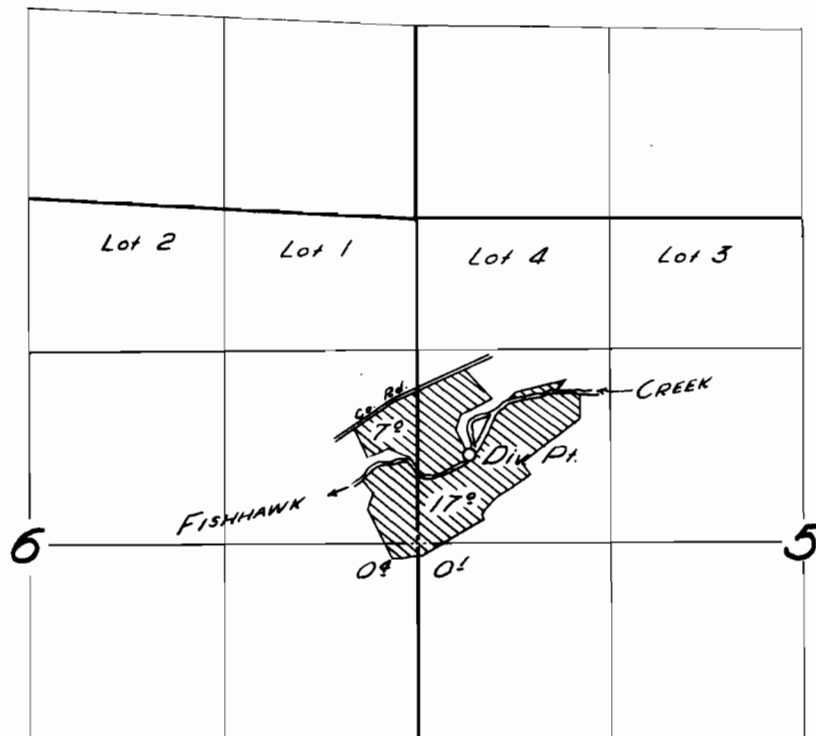

FINAL PROOF SURVEY
UNDER

Application No. 27986 Permit No. 22029
IN NAME OF

A. J. SEIBEL

Surveyed 6 Sept. 1956, by [Signature]