


T. 38 S., R. 3 W., W.M.

28 27
33 34

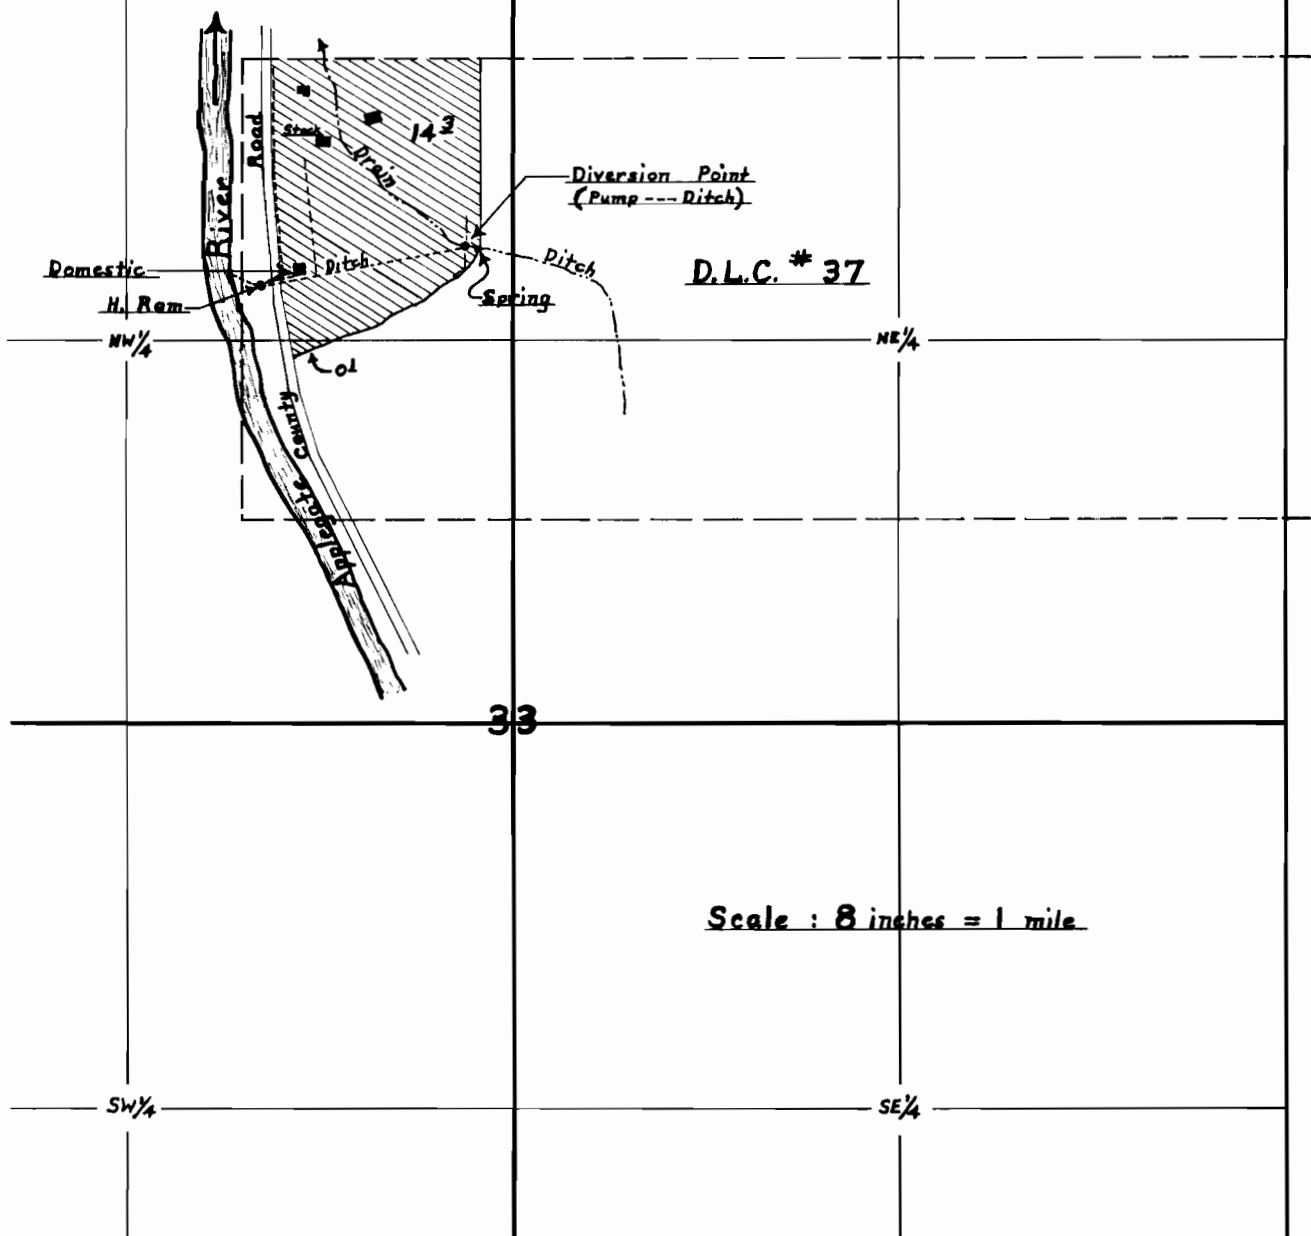

D.L.C. # 37

Scale : 8 inches = 1 mile

FINAL PROOF SURVEY

UNDER

Application No. 28521 Permit No. 22323

IN NAME OF

James T. Buckley

Surveyed March 7, 1957, by D.C. Hendrix, W.M.