


T. 4 S. R. 1 W. W.M.

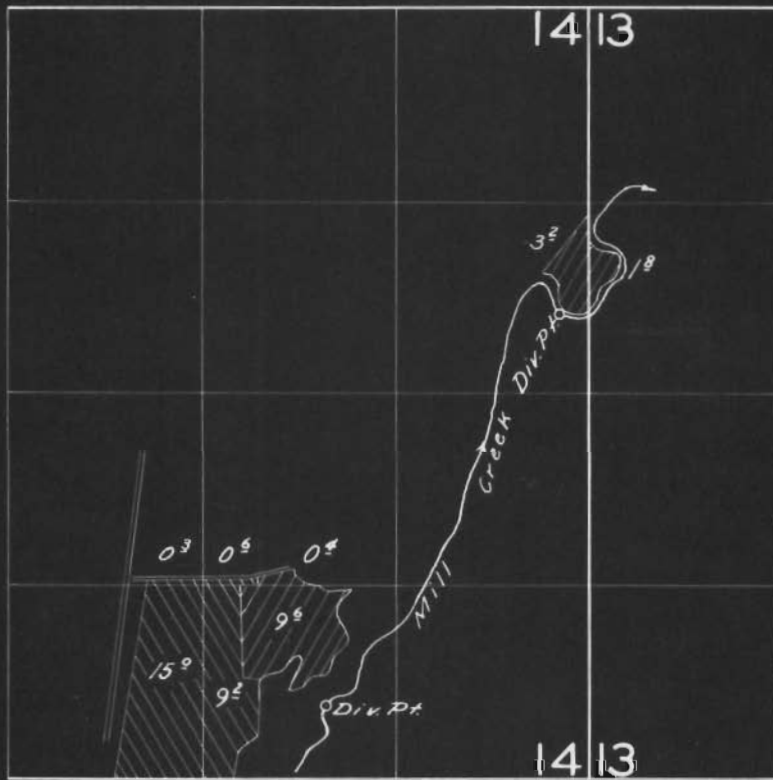

FINAL PROOF SURVEY

UNDER

Application No. 28910 Permit No. 22758
24135 18998

IN NAME OF

Walter P. Koenig

Surveyed June 22 1956, by C. O. Bartels