


T. 2 S. R. 5 E. W.M.

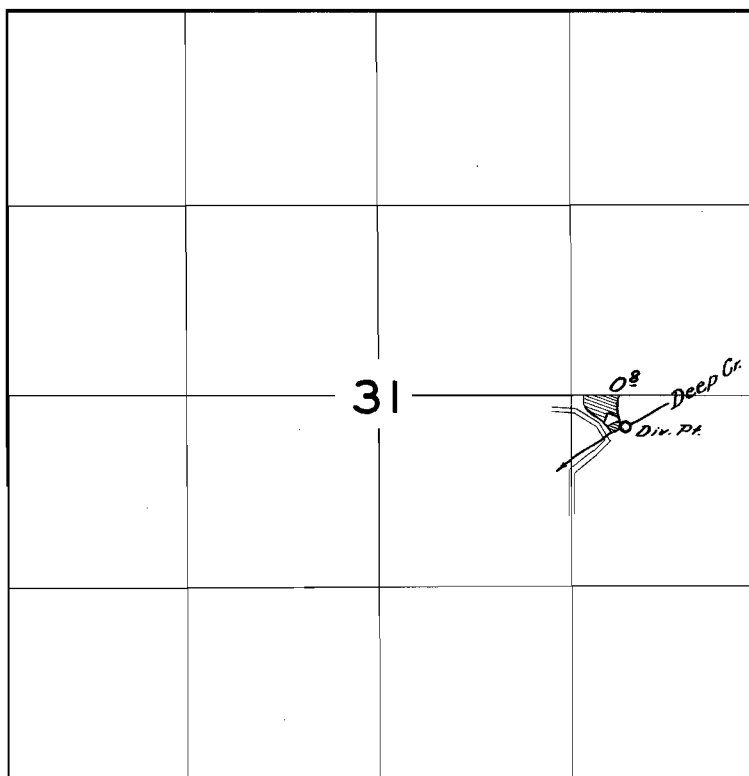

FINAL PROOF SURVEY
UNDER

Application No. 29458 Permit No. 23183
IN NAME OF

L. H. CROSBY

Surveyed June 19 1956, by R. H. Whitely