


T. 6 S. R. 6 W. W. M.

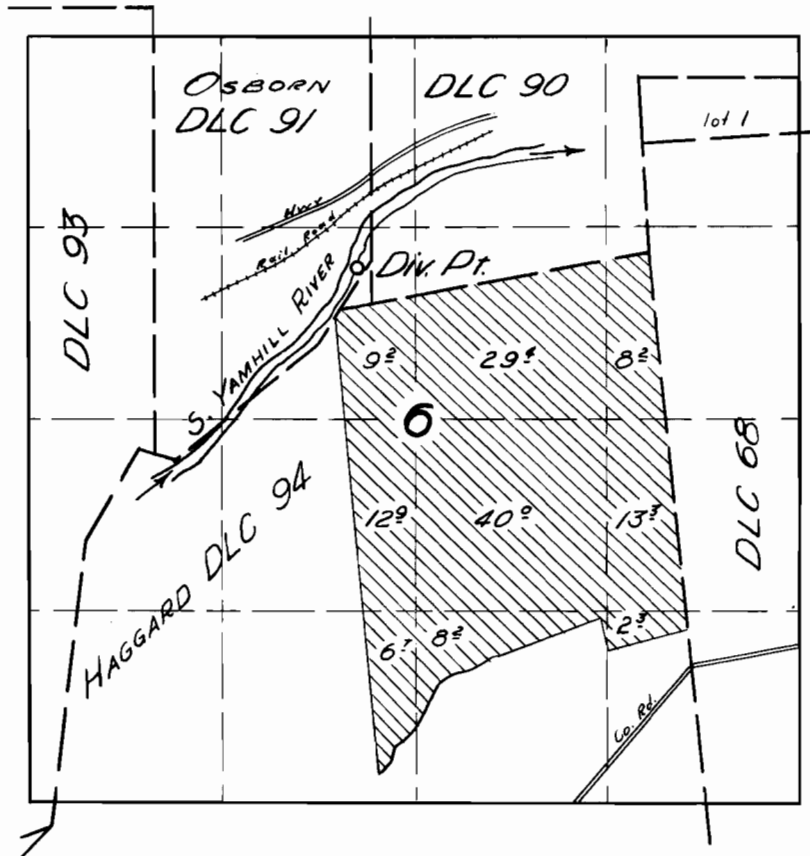

FINAL PROOF SURVEY

UNDER

Application No. 29003 Permit No. 23232

IN NAME OF

ELMER SHARER

Surveyed 14 Mar 1956, by [Signature]