


T. 3S. R. 1W. W.M.

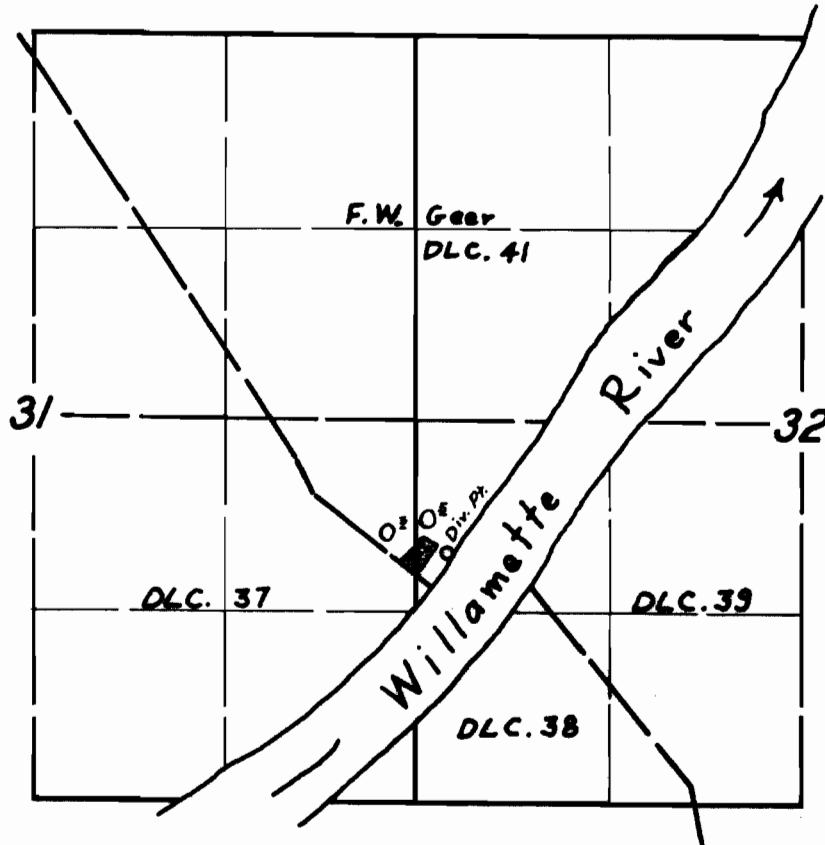

**FINAL PROOF SURVEY**

UNDER

Application No. 29505 Permit No. 23245

IN NAME OF

DR. HERBERT V.H. THATCHER

Surveyed 16 May, 1956, by M. Bish