


T. 4 S. R. 2 E. W. M.

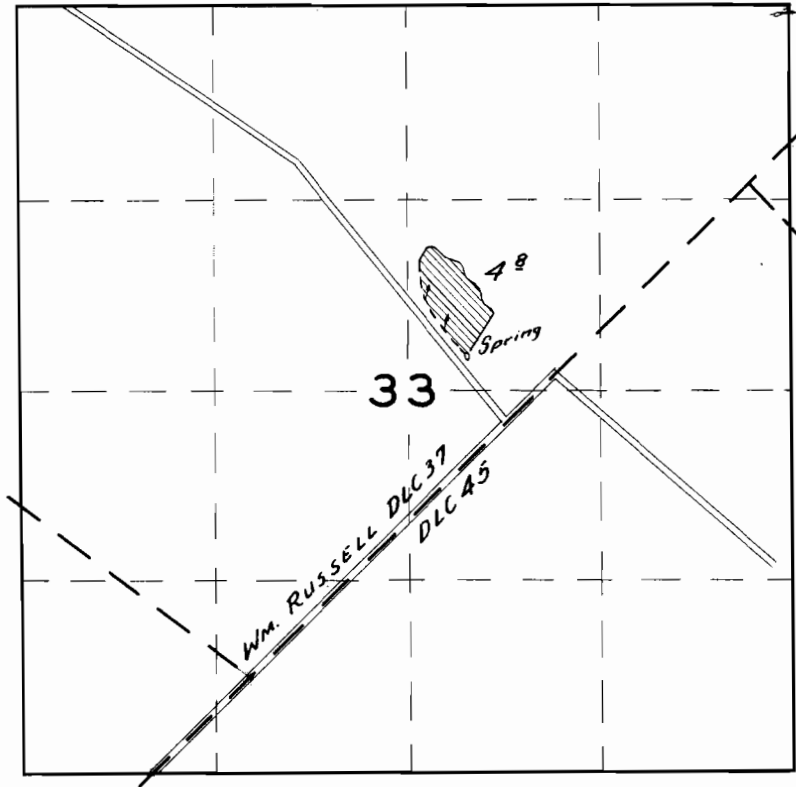

FINAL PROOF SURVEY

UNDER

Application No. *30035*. Permit No. *23960*.

IN NAME OF

LEW. E. WALLACE

Surveyed *Sept. 24 1956*, by *C.O. Bartels*.